


T.2S., R.44E., W.M.

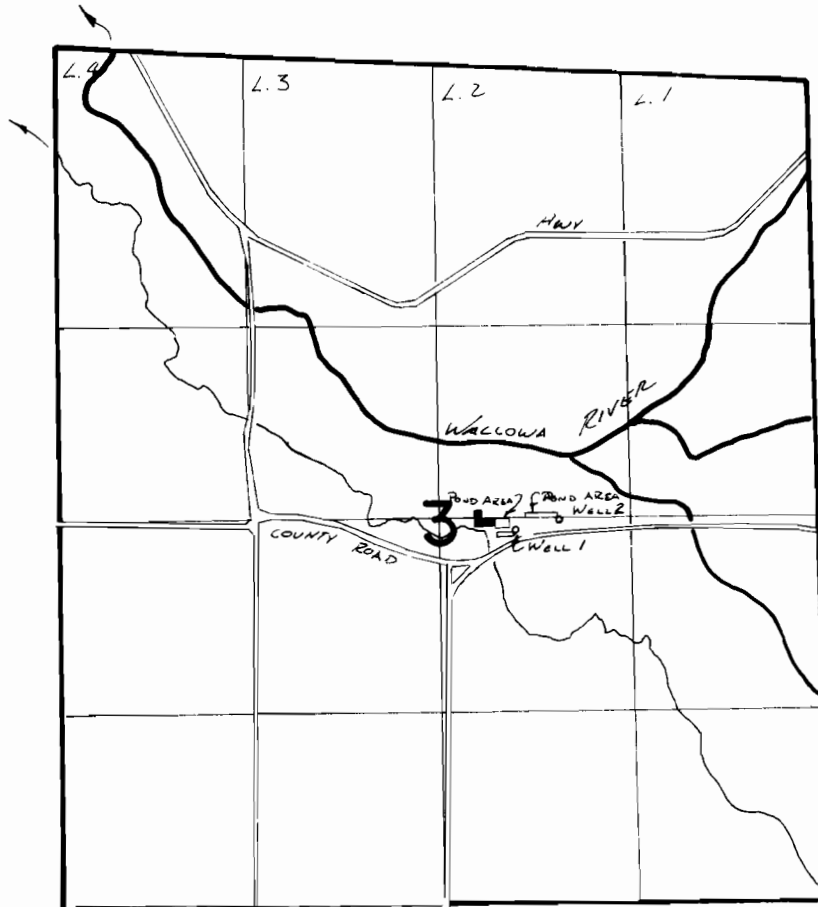

WELL 1 LOC: 80' S. & 520' E FROM CENTER SEC. 3
WELL 2 LOC: 10' S. & 820' E FROM CENTER SEC 3

FINAL PROOF SURVEY
UNDER

Application No. G:9203 Permit No. G:8610.....
IN NAME OF

OREGON DEPT. OF FISH & WILDLIFE

Surveyed 8-12..... 1987, by V.H. Church.....