


# T. 4S. R. 13E. W. M.

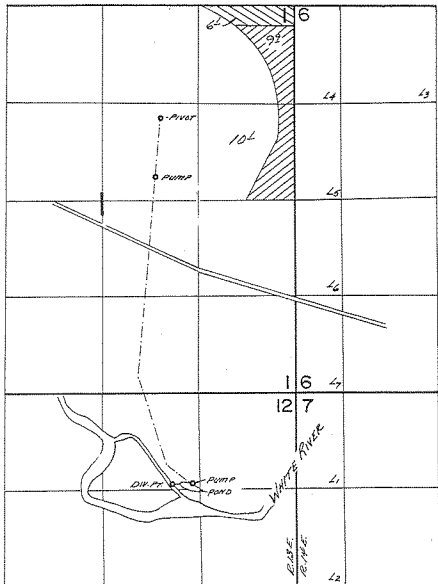

Div. Pl. Loc. 1430' N of 930' E from Center Sec. 12

SEPT. 29, 1972  JAN. 2, 1974 

## FINAL PROOF SURVEY

UNDER

Application No. 497.7.8., Permit No. 37.8.95.....  
 IN NAME OF

.....**GENE REYNOLDS**.....

Surveyed Sept. 12, 1979., by C.R. RODRIGUEZ.