


T.4S., R.13&14E., W.M.

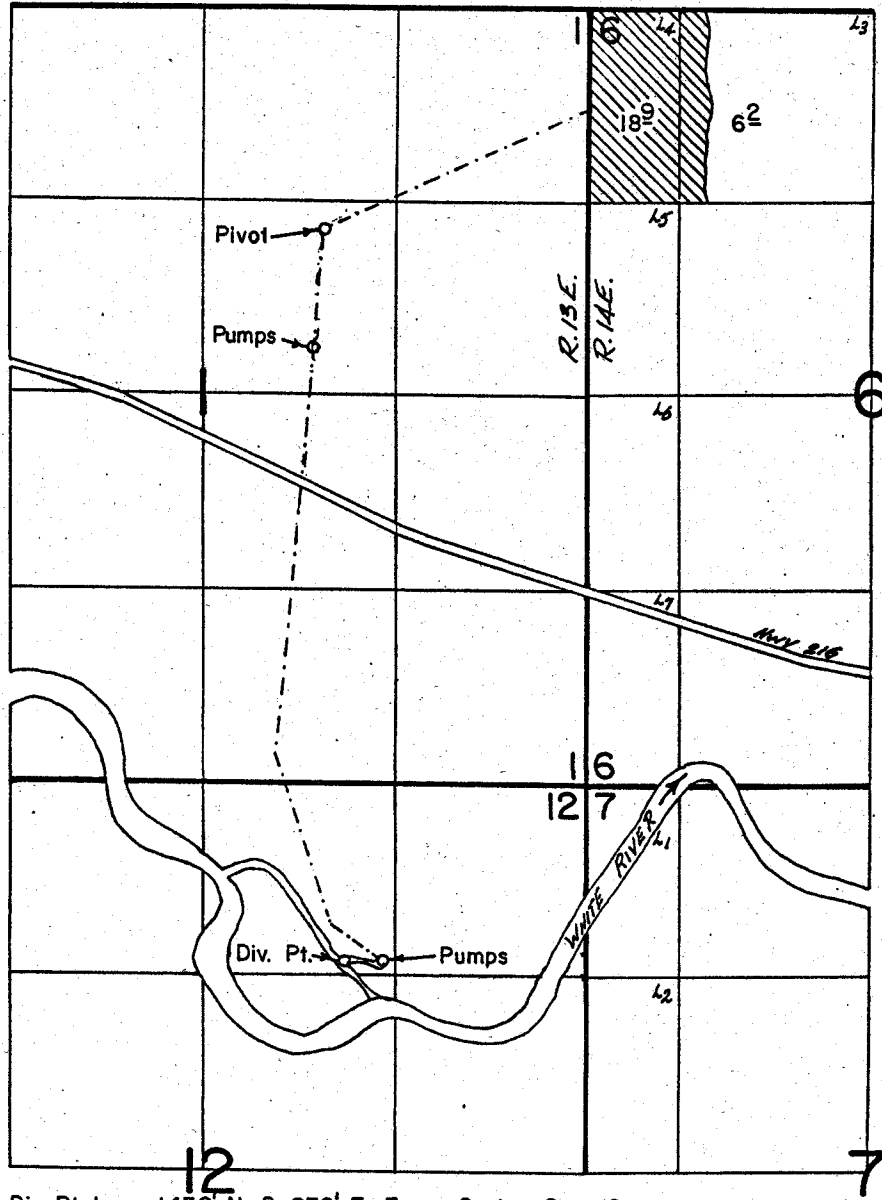

Div. Pt. Loc.: 1430' N. & 930' E. From Center Sec. 12

**FINAL PROOF SURVEY**  
UNDER

Application No. 55989... Permit No. 41939...  
IN NAME OF

..... GENE L. REYNOLDS .....

Surveyed Nov...3... 1982, by T.J. Paul.....