


T.6S., R.21E., W.M.

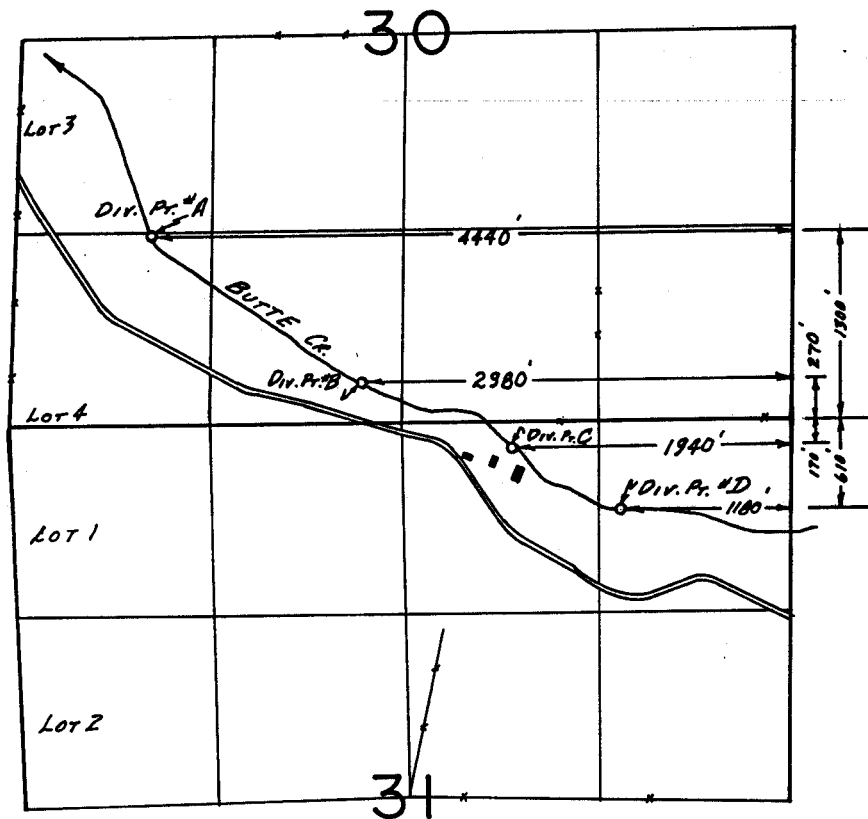

**FINAL PROOF SURVEY**  
UNDER

Transfer No. 3632  
Application No. .... Permit No. ....  
IN NAME OF

**MORRIS E. WILSON - WILSON RANCHES**

Surveyed JUNE 25, 1980, by S.C. BROWN.....