




P 26849
 SUP 42568
 51743
 55044

T.6S.R.21E.W.M.

see also
 P 26848

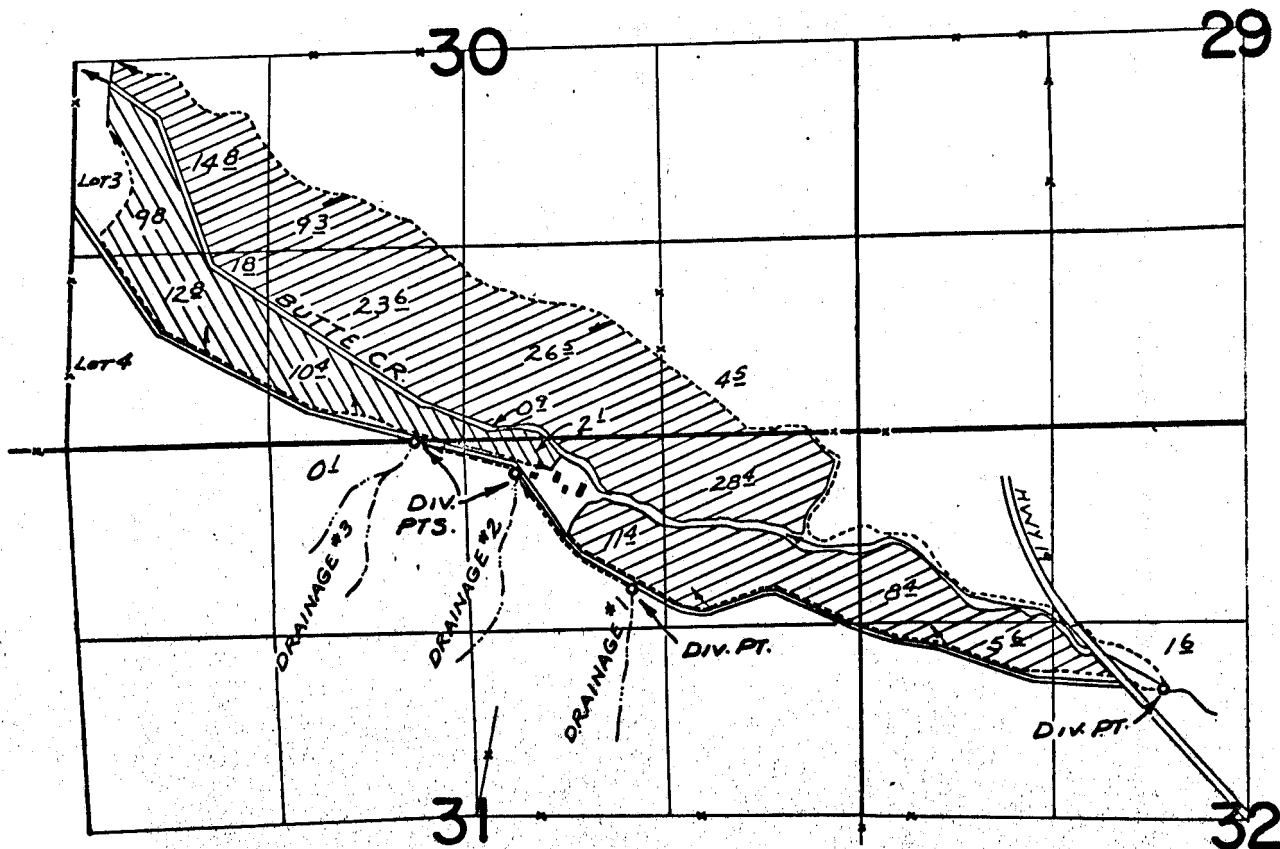

DIV. PTS. LOC: BUTTE CR. - 1800'S. & 2070'E.; UNN. DRAIN #1 - 1050'S. & 1550'W; #2 - 240'S. & 2350'W; #3 - 10'S. & 3030'W., ALL FROM N.E. COR. SEC. 31

 LAND IRRIGATED FROM BUTTE CR. ONLY  LAND FOUND IRRIGATED FROM BUTTE CR. & 3 DRAINAGES

FINAL PROOF SURVEY
 UNDER

Application No. ³⁴⁰⁵⁶~~34057~~..... Permit No. ²⁶⁸⁴⁸~~26849~~.....
 IN NAME OF

MORRIS E. & VIOLA M. WILSON

Surveyed JULY 10, 1968, by K. GARNER