


T12S. R6W. WM.

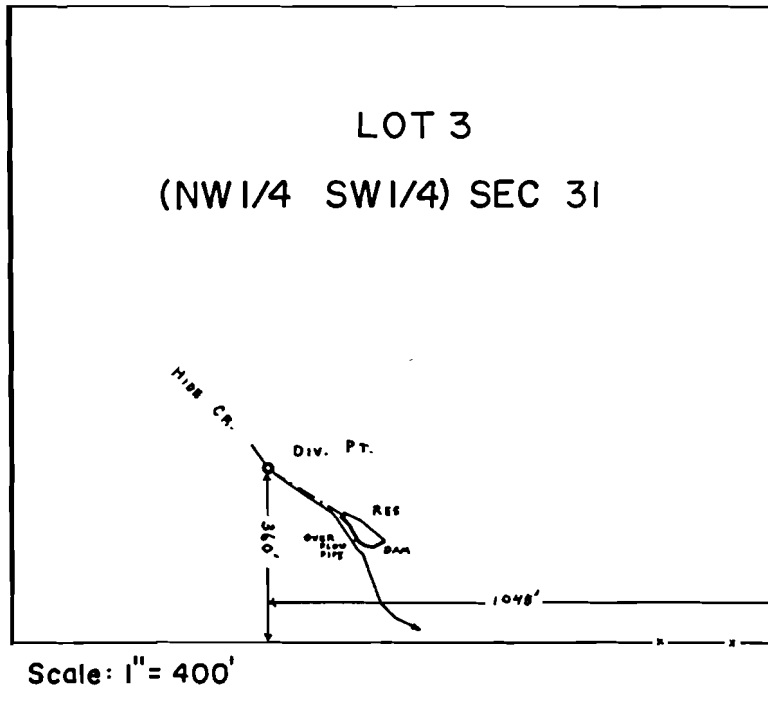

**FINAL PROOF SURVEY**  
UNDER

R-57184                      R-7763  
Application No. 57558.. Permit No. 43759.....  
IN NAME OF

.....**JOHN E. KELLEY**.....

Surveyed Oct. 4 1979, by C. L. HUGHES.....