


T12S. R6W. WM.

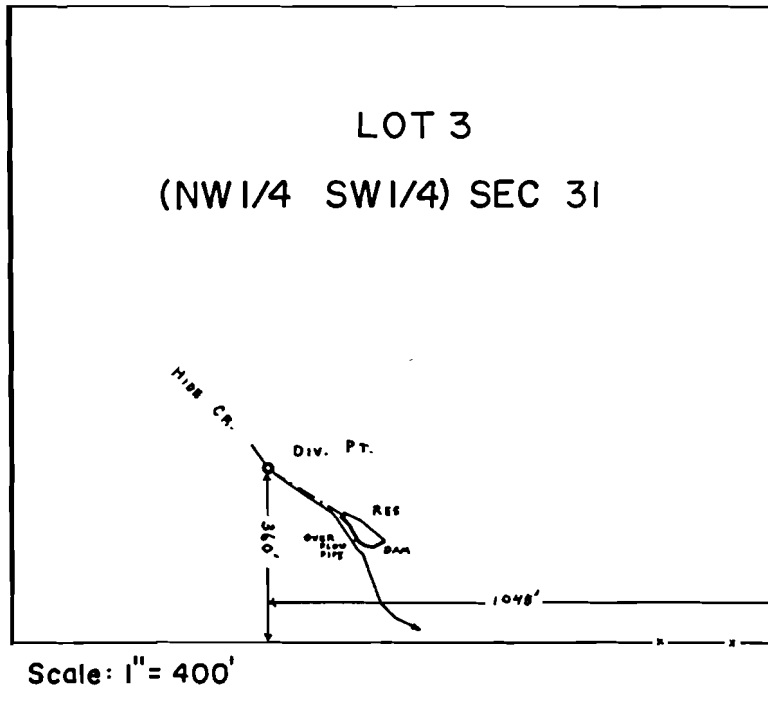

FINAL PROOF SURVEY
UNDER

R-57184 R-7763
Application No. 57558.. Permit No. 43759.....
IN NAME OF

.....**JOHN E. KELLEY**.....

Surveyed Oct. 4 1979, by C. L. HUGHES.....