


T.3S.R.3E.W.M.

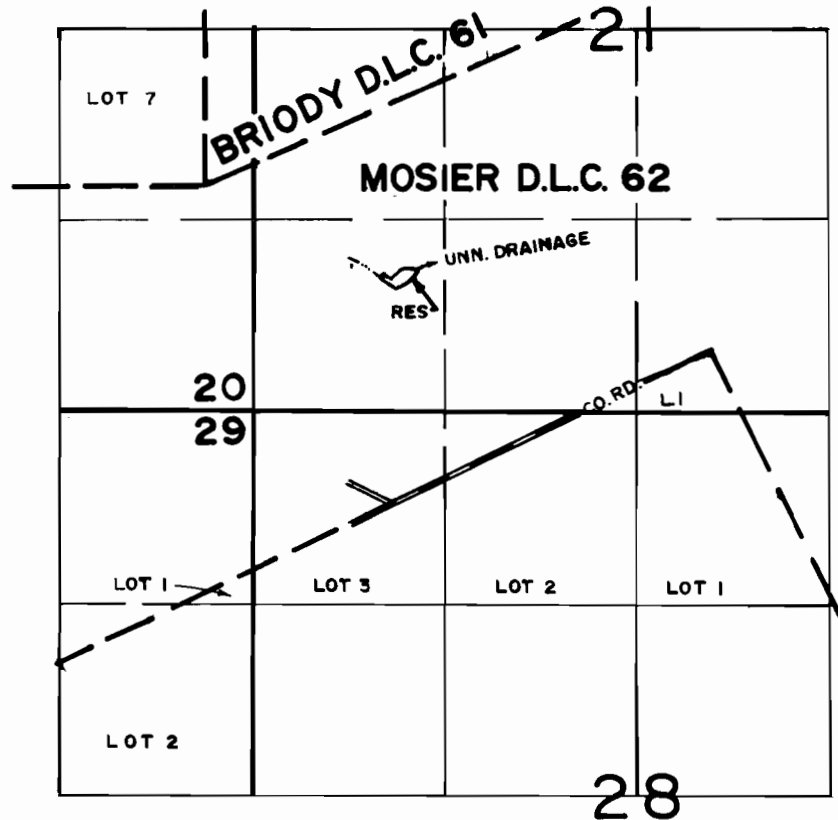

Dam Located: 970 H.N. & 1120 H.E., from SW corner Sec. 21

FINAL PROOF SURVEY
UNDER

R-52488 R-6350
Application No. 52590 Permit No. 39601.....
IN NAME OF

.....SKYHILL FARM.....

Surveyed MAR. 14... 1980, by R.G. MUCKEN.....