


T.4S. R.1E. W.M.

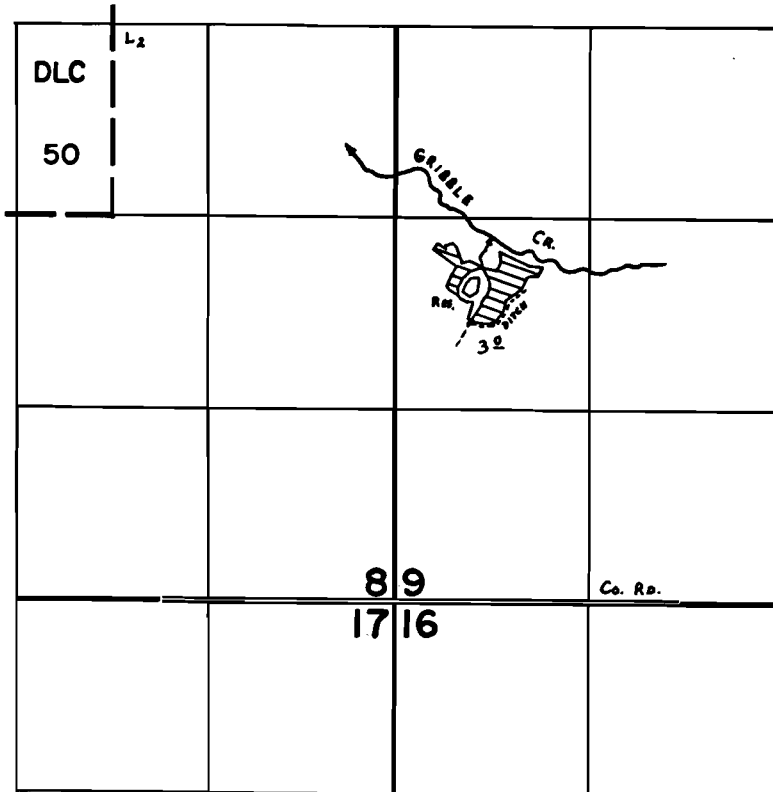

DAM Loc: 2290' N. { 590' E. fr. S.W. Cor. Sec. 9.

FINAL PROOF SURVEY UNDER

R-56348 R-6652
Application No. ~~56349~~ Permit No. ~~41993~~.....
IN NAME OF

RICHARD FREDERICK BUSH.....

Surveyed Oct.....9... 19.79., by ..G..L..HUGHES.....