


T.3S.R.IW.W.M.

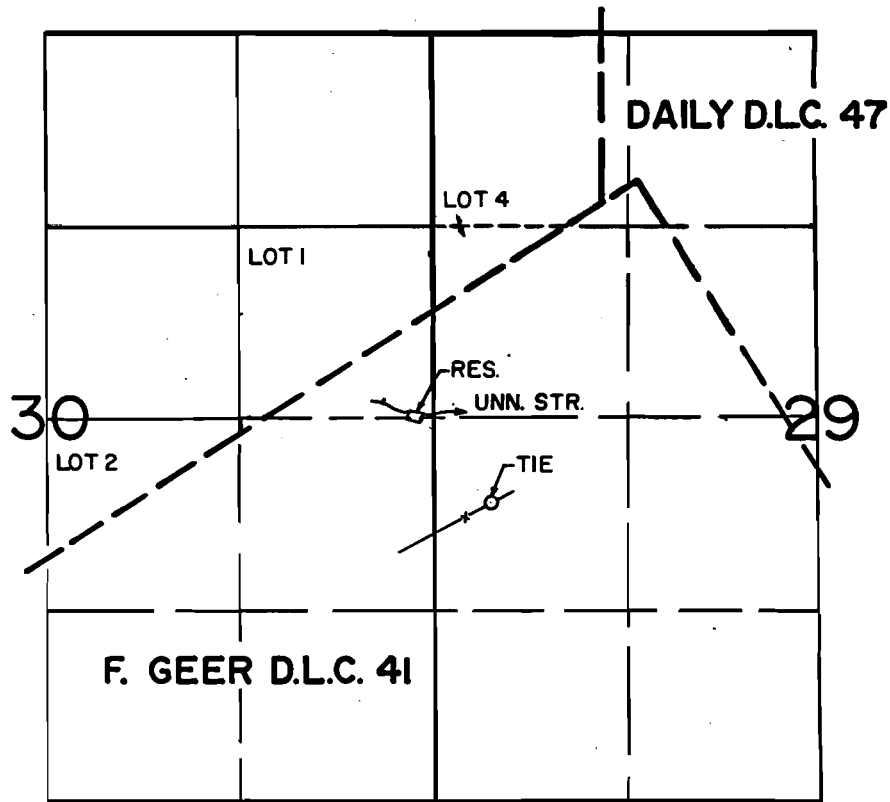

DIV. PT. LOC.: 100' W. FROM THE E. 1/4 CORNER SECTION 30

FINAL PROOF SURVEY

UNDER

Application No. 55918 R-55917 R-6766
Permit No. 42638
IN NAME OF

PETER G. McDONALD

Surveyed JAN 15 1980, by R.G. MUCKEN.....

REVISED 4-23-86 *gcl*
REM

DFK-2LL-9 & 1979-H-1