


T.5S., R.1W., W.M.

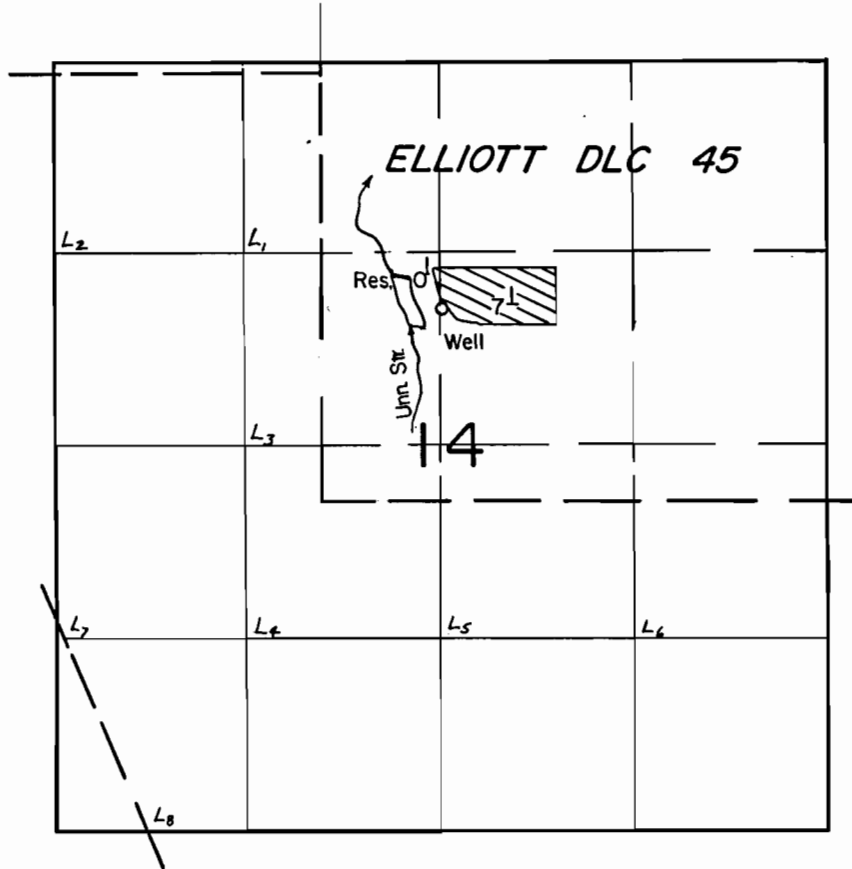

Well Loc.: 1320' N. & 810' E. from SW Cor. DLC 45.

Dam Loc.: 1520' N. & 520' E. from SW Cor. DLC 45.

Scale: 1" = 1320'

**FINAL PROOF SURVEY**  
UNDER

G-10723

G-9952

R-60076

R-8170

Application No. 60077.. Permit No. 45030.....

IN NAME OF

**BESS & ELDON C. LOWTHER**

Surveyed JULY 15, 1985., by T. Warren.....