


T.5S., R.1W., W.M.

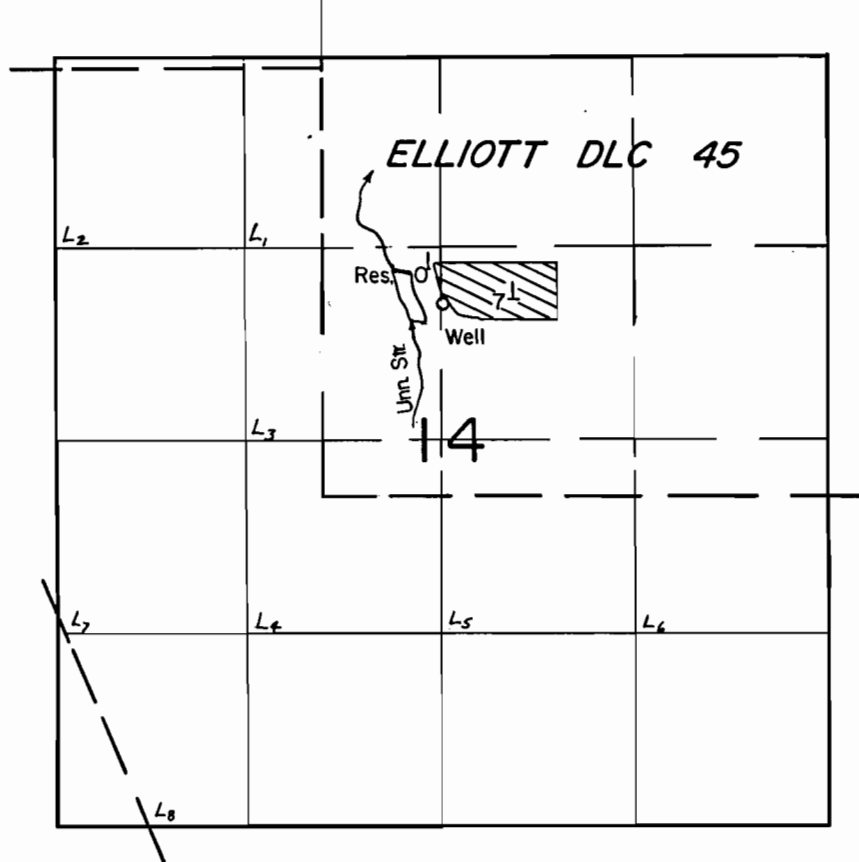

Well Loc.: 1320' N. & 810' E. from SW Cor. DLC 45.

Dam Loc.: 1520' N. & 520' E. from SW Cor. DLC 45.

Scale: 1" = 1320'

FINAL PROOF SURVEY
UNDER

G-10723 G-9952
R-60076 R-8170

Application No. 60077.. Permit No. 45030.....

IN NAME OF

BESS & ELDON C. LOWTHER

Surveyed JULY 15, 1985, by T. Warren.....