


T. 3S., R. 1W., W.M.

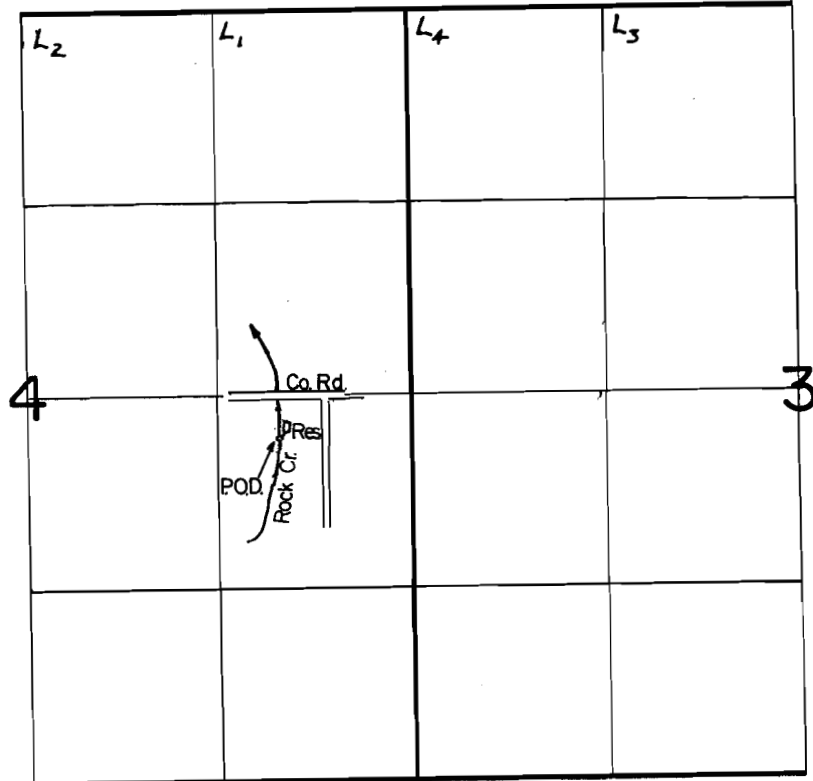

P.O.D. Loc. 2350' N. & 900' W. from SE Cor. Sec. 4.

Scale: 1" = 1320'

**FINAL PROOF SURVEY**  
UNDER

R-62371                      R-8464  
Application No. 62372.. Permit No. 46845.....  
IN NAME OF

.....**SHARON BUTLER**.....

Surveyed AUG. 22 1985., by T. Warren.....