


T. 3S., R. 1W., W.M.

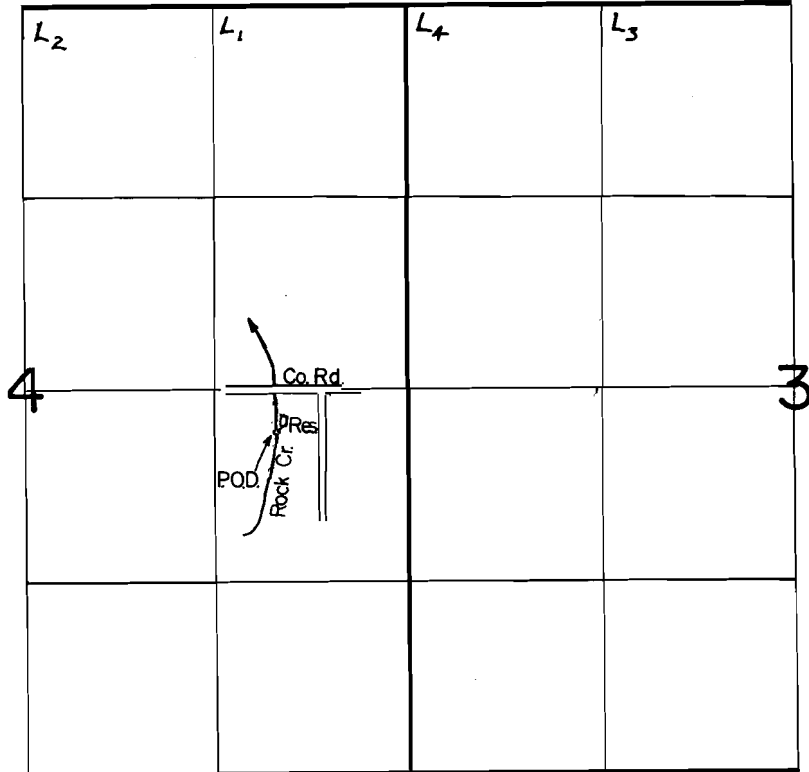

P.O.D. Loc. 2350' N. & 900' W from SE Cor. Sec. 4.

Scale: 1" = 1320'

FINAL PROOF SURVEY
UNDER

R- 62371 R-8464
Application No. 62372.. Permit No. 46845.....

IN NAME OF

.....**SHARON BUTLER**.....

Surveyed AUG...22 1985., by T. Warren.....