


T.4S. R.2E. W.M.

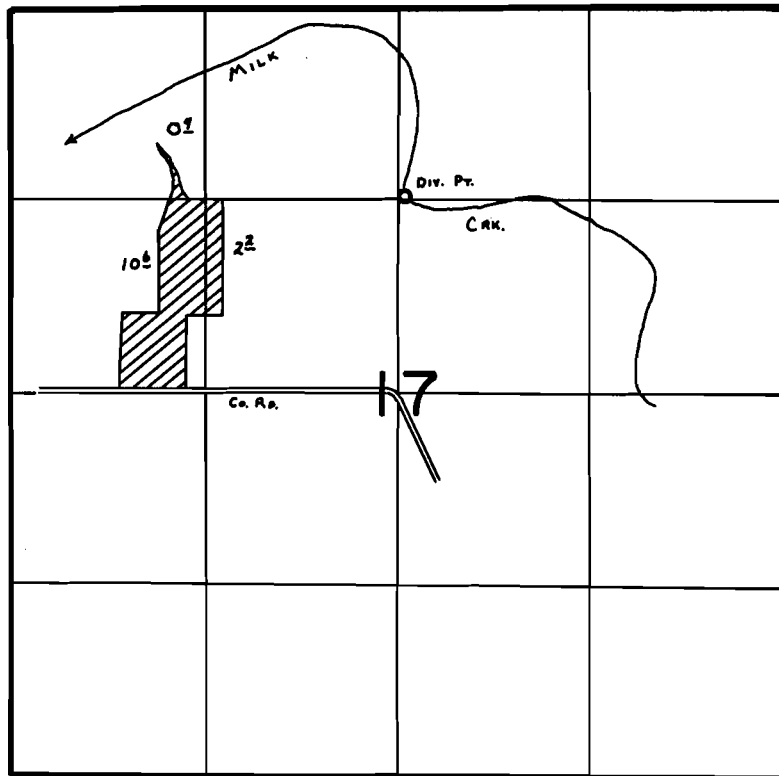

Div. Pt. Loc: 1300'S. 1/2 50'E. fr. N. 1/4 Cor. Sec. 17.

FINAL PROOF SURVEY
UNDER

Transfer No. T-4316
Application No. 53367.. Permit No. 39593.....
IN NAME OF

.....HAYRE'S EGG FARMS, INC.....

Surveyed Oct.....18.. 19.79, by C.L. HUGHES.....