


T.2S.R.3E.W.M.

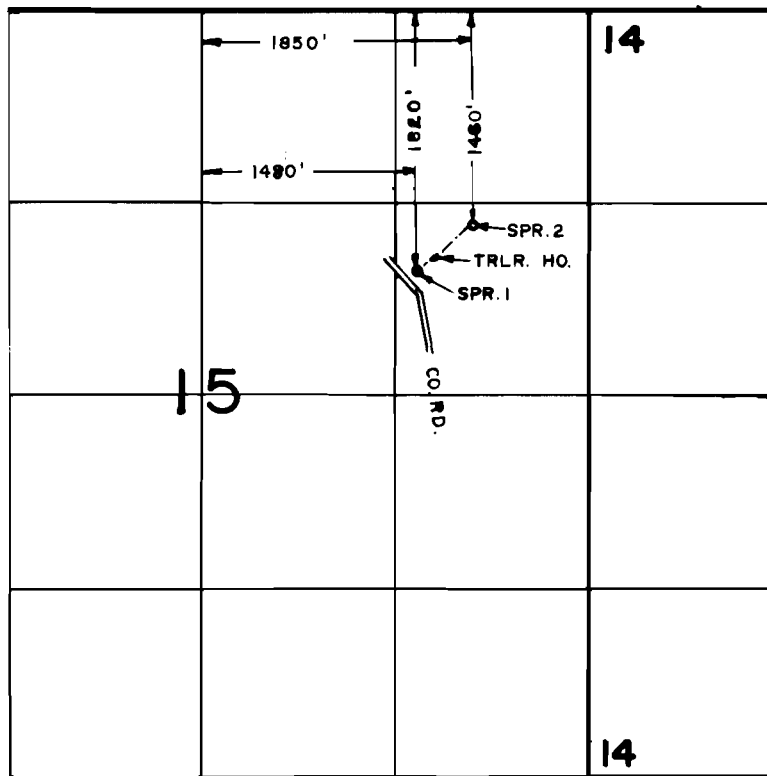

FINAL PROOF SURVEY UNDER

Application No. 53445 Permit No. 39766
IN NAME OF

HOWARD R. CHRISTENSEN

Surveyed MAR. 18, 1980, by R.G. MUCKEN