




T. 2 S., R. 2 E., W.M.

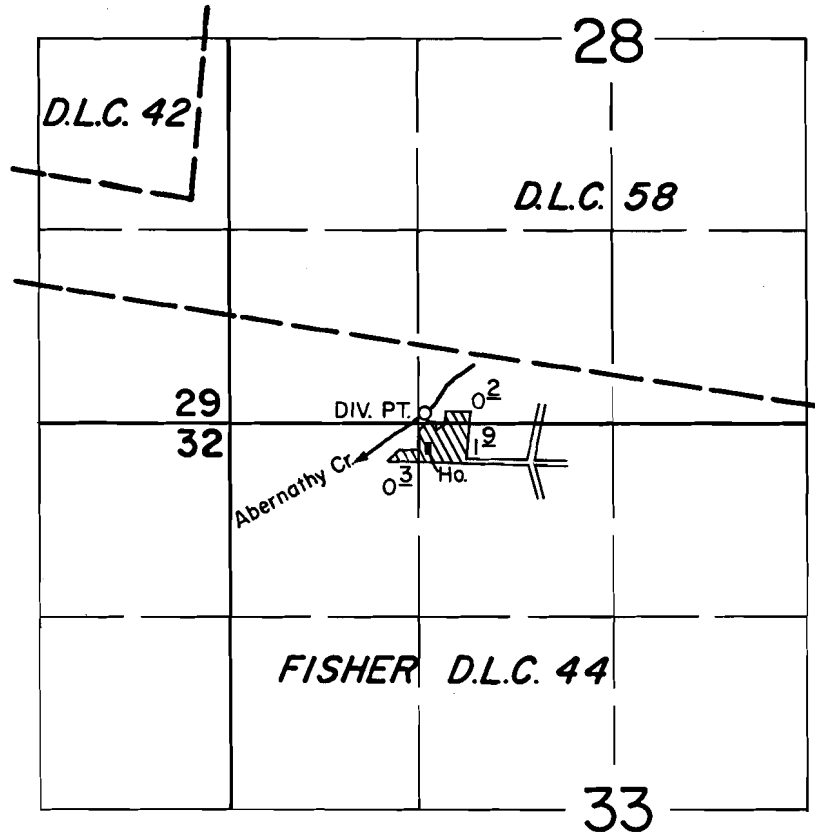

DIV. PT. LOC: 70' N. & 1370' E. FROM THE SW. CORNER OF SECTION 28

SCALE: 1" = 1320'

FINAL PROOF SURVEY
UNDER

Application No. 56661... Permit No. 42608.....
IN NAME OF

STANLEY L. & MARY ANN COOK.

Surveyed MARCH 28 1980, by R.G. MUCKEN.....