


T. 3S., R. 2E., W.M.

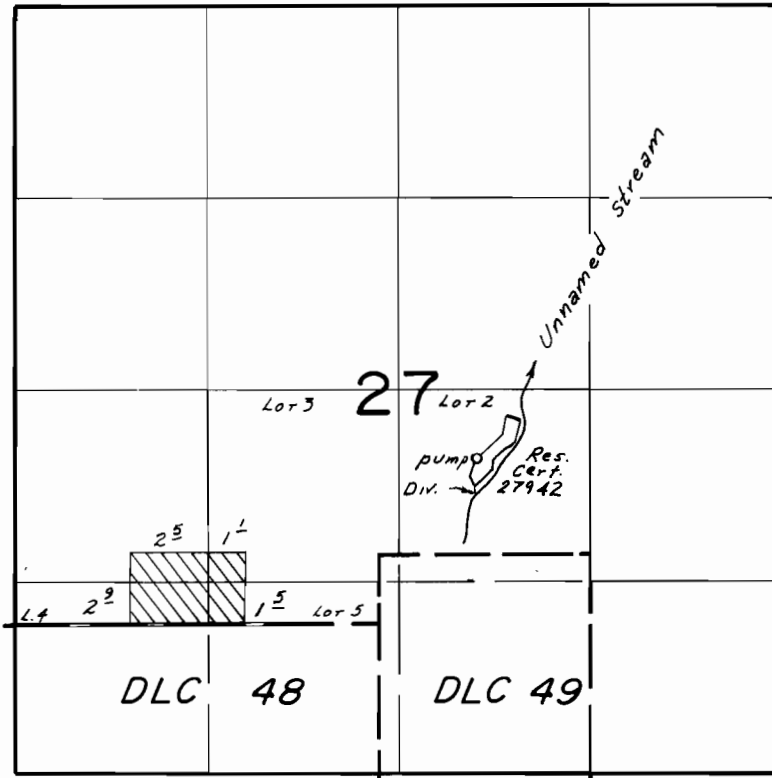

*DIV. PT. LOC: 710'S. & 510'E. FROM CENTER SEC. 27*

SCALE: 1" = 1320'

**FINAL PROOF SURVEY**  
UNDER

Application No. 57265.. Permit No. 43084.....  
IN NAME OF

DORIS L. ROUSETT

Surveyed AUG. 9.... 1984., by B.W. BISHOP.....