


T.5S., R.1W., W.M.

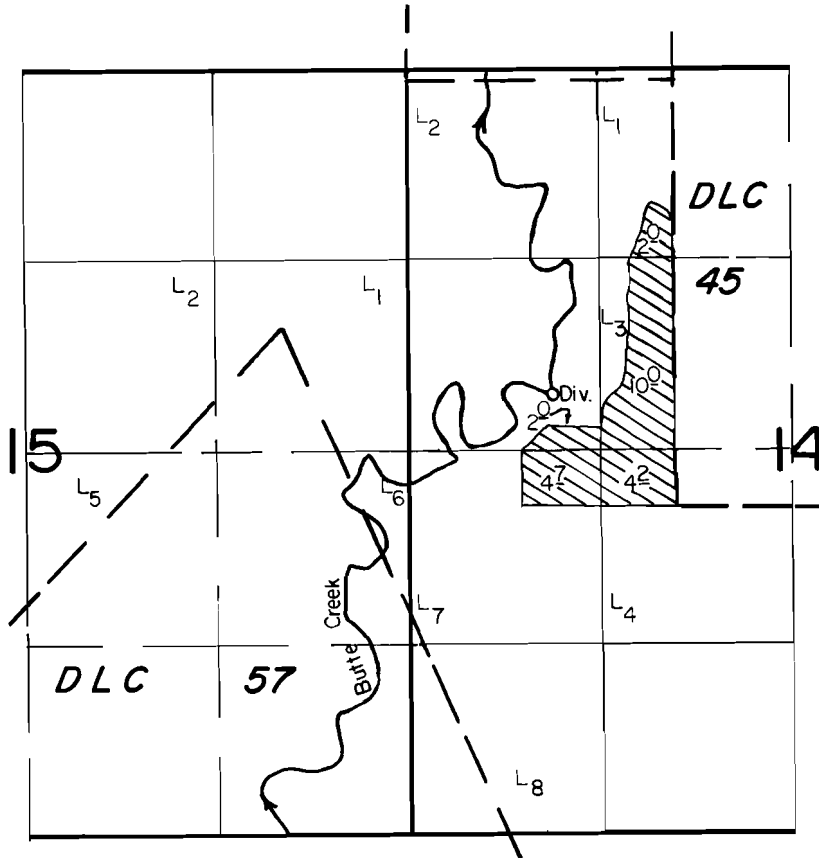

Div. Loc. : 390' N. & 1000' E. from W. 1/4 Cor. Sec. 14.

Scale: 1" = 1320'

FINAL PROOF SURVEY
UNDER

Application No. 58749... Permit No. 44302.....
IN NAME OF

.....**MIKE SAMARIN**.....

Surveyed JUNE 28, 1985, by T. Warren.....