


T. 5S., R. 1W., W.M.

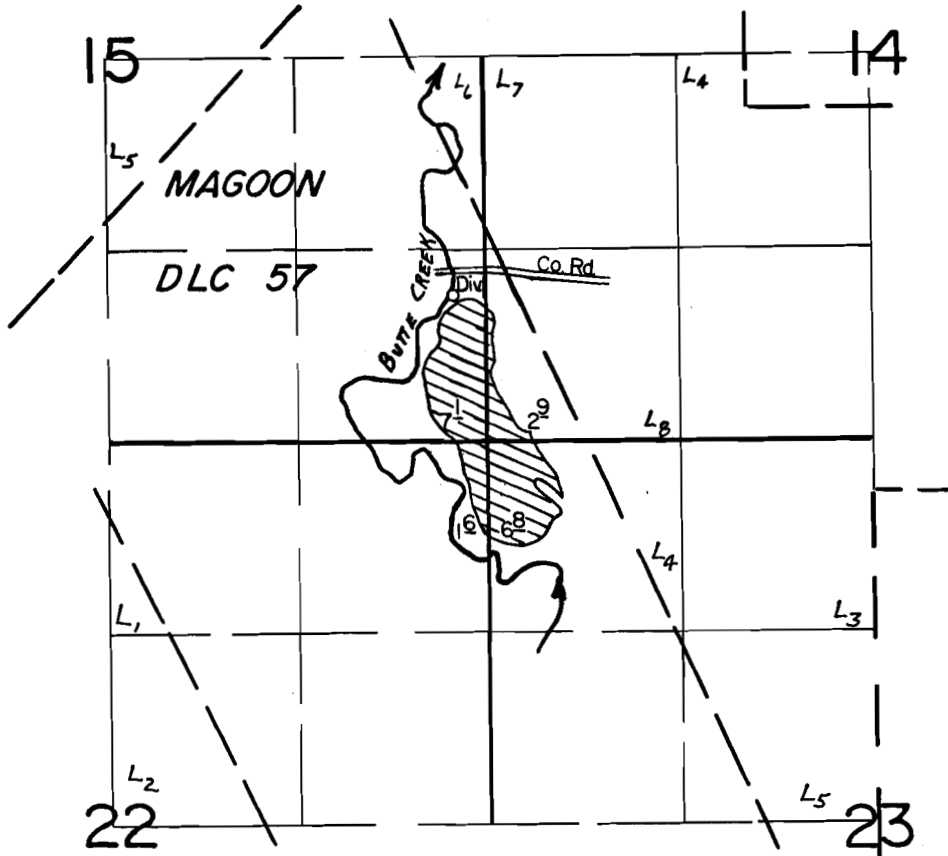

Div. Loc. : 1000' N. & 220' W. from SE Cor. Sec. 15.

Scale: 1" = 1320'

**FINAL PROOF SURVEY**  
UNDER

Application No. 61118..... Permit No. 45672.....

IN NAME OF

**MARVIN O. BOLLAND**

Surveyed JUNE..27. 1985., by J. Warren.....