




T. 3 S., R. 1 E., W.M.

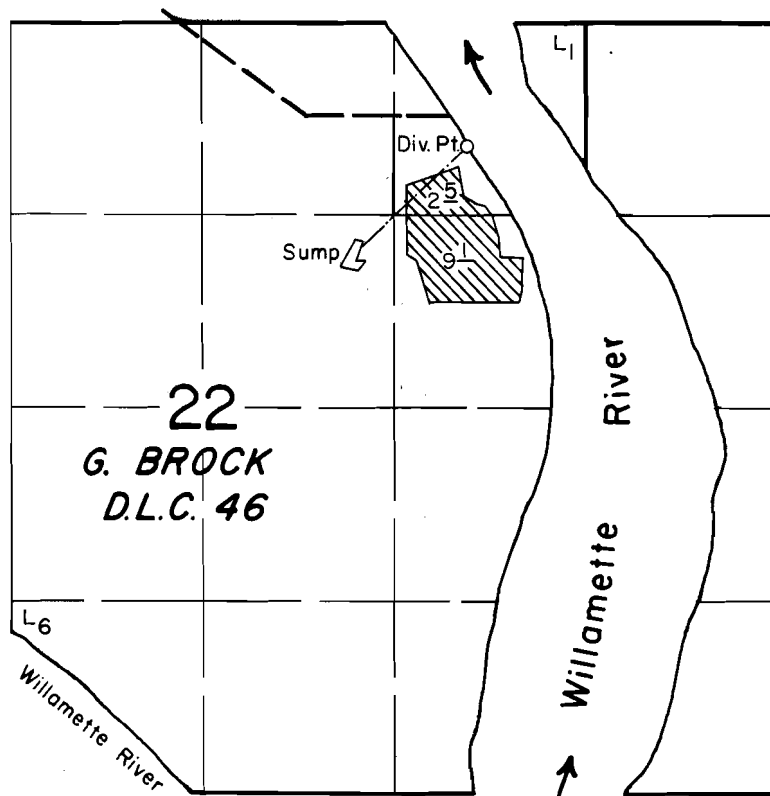

DIV. PT. LOC: 850' S. & 820' W. FROM THE N.E. CORNER SEC. 22

SCALE: 1" = 1320'

FINAL PROOF SURVEY UNDER

Application No. 62324 Permit No. 45994
IN NAME OF

JOHN WILLIAM BRADLEY

Surveyed AUG. 21, 1985, by T. WARREN