


T.2S.R.38&4E.W.M.

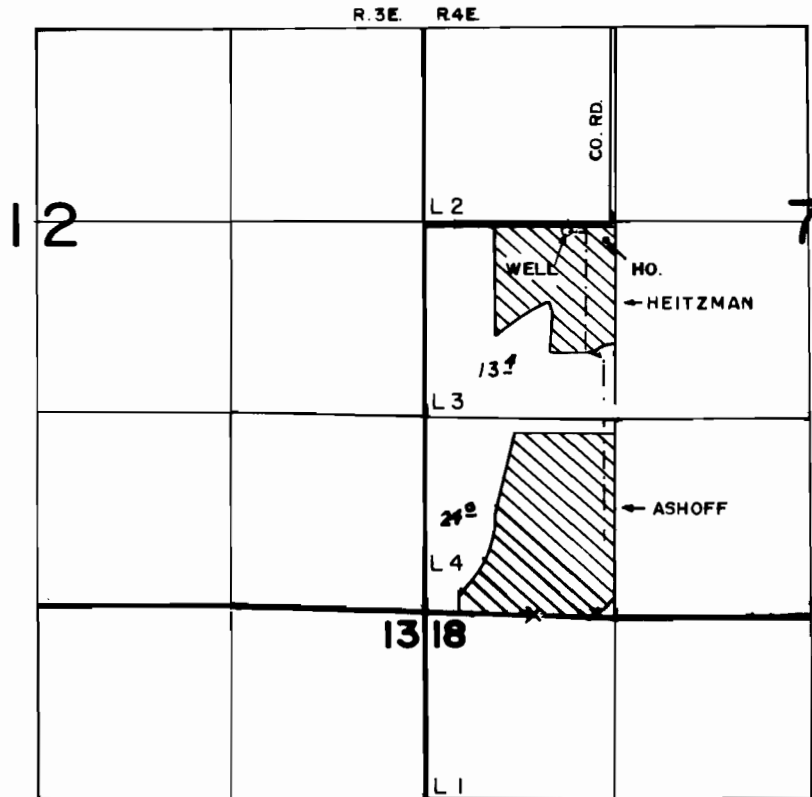

WELL LOC.: 30' S. & 990' E. FROM W. 1/4 COR. SEC. 7

FINAL PROOF SURVEY UNDER

Application No. ~~G-5559~~. Permit No. ~~G-5160~~.....
IN NAME OF

.....MURRAY J. HEITZMAN.....

Surveyed MAR. 26.. 1980., by R.G.MUCKEN.....