


T.38&4S.R.2E.W.M.

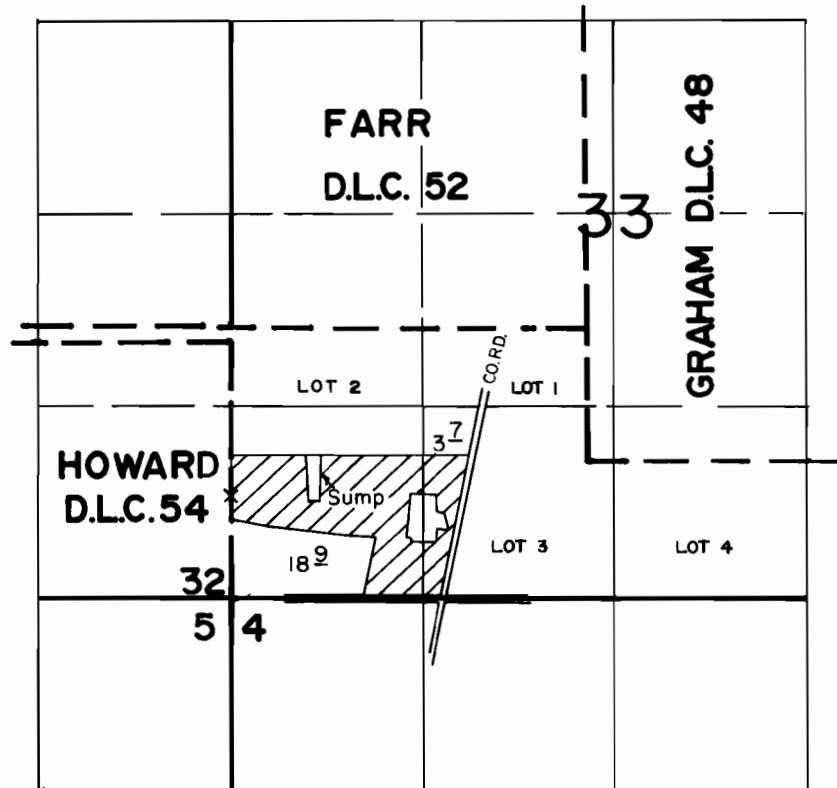

DIV. PT. LOC.: 1000' N. & 600' E. FROM S.W. CORNER SECTION 33

FINAL PROOF SURVEY UNDER

Application No. G-6652 Permit No. G-6001.....
IN NAME OF

.....MYRON M. MUELLER.....

Surveyed MAR. 14. 1980, by R.G. MUCKEN.....

Revised 5-6-86, 41005-278-177B

1980-H-1

REM

fx