


T. 4 S., R. 1 E., W.M.

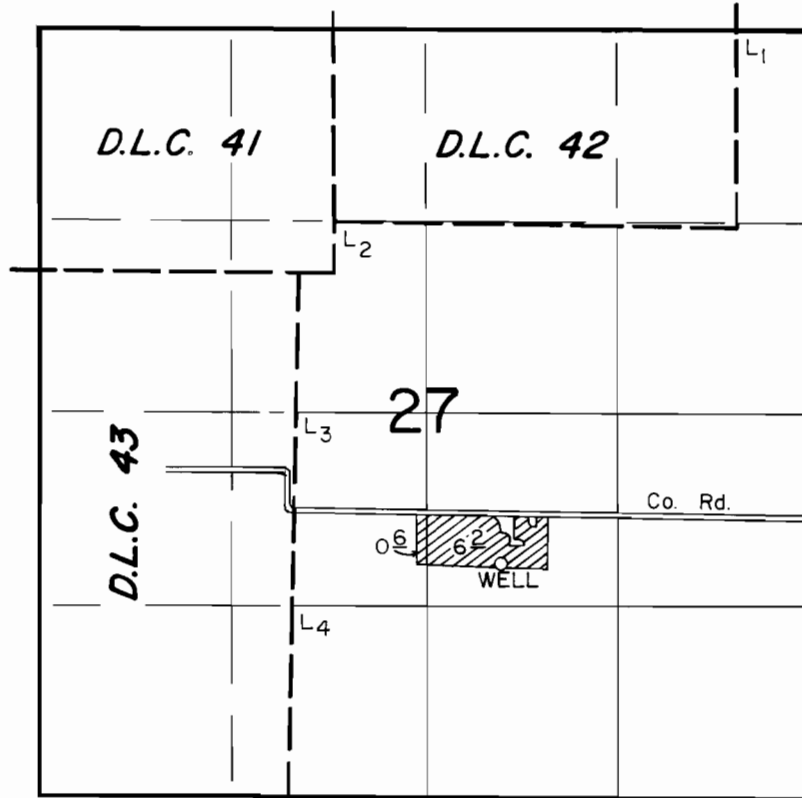

WELL LOC: 1000' S. & 500' E. FROM THE CENTER SECTION 27

SCALE: 1" = 1320'

FINAL PROOF SURVEY
UNDER

Application No. G-6635. Permit No. G-6204...
IN NAME OF

.....FREDERIC S. CLYDE.....

Surveyed JULY 2, 1985, by T. WARREN.....