




T.3S.R.1E.W.M.

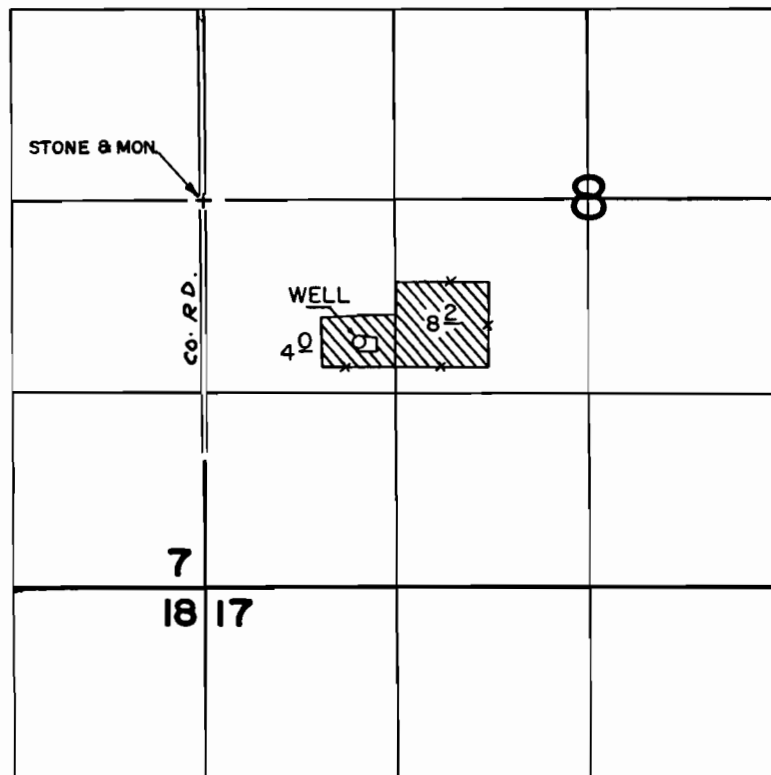

WELL LOC: 970' S. & 1050' E. FROM W. 1/4 CORNER SEC. 8

FINAL PROOF SURVEY UNDER

Application No. G-6990 Permit No. G-6496
IN NAME OF

.....EDWARD C. MEEK, JR.....

Surveyed JAN. 18... 1980, by R.G. MUCKEN.....

Revised 5-7-86

1979-H-1

REM