


# T.2S.R.3E.W.M.

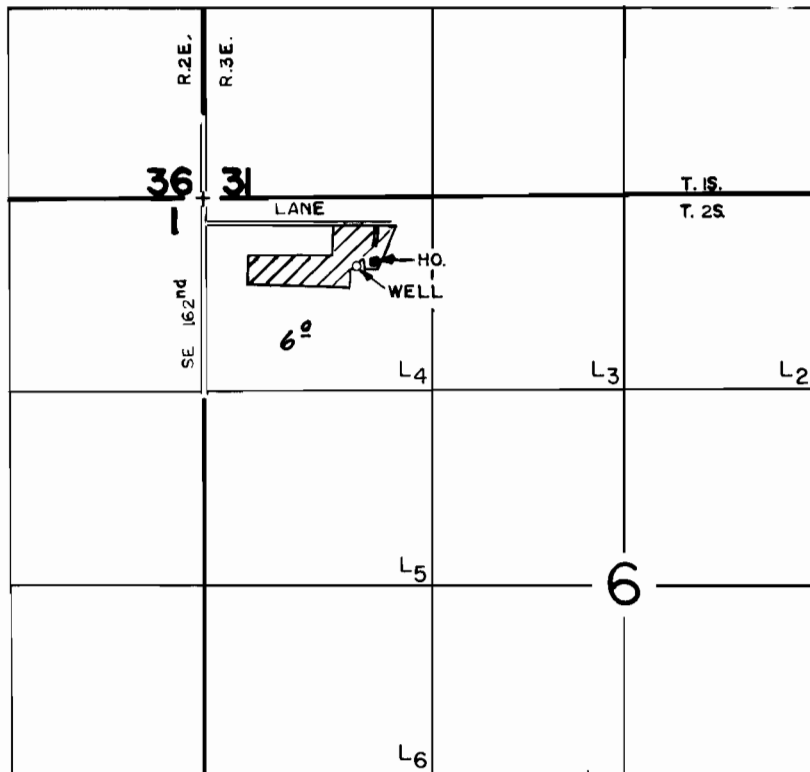

WELL LOC. : 460' S. & 1050' E. FROM NW. COR. SEC. 6

## FINAL PROOF SURVEY UNDER

Application No. 9-7162. Permit No. 9-6607....  
IN NAME OF

.....JOHN...BROCKAMP.....

Surveyed MAR. 27... 19.80, by .R.G.MUCKEN.....