


T. 3S., R. 2E., W.M.

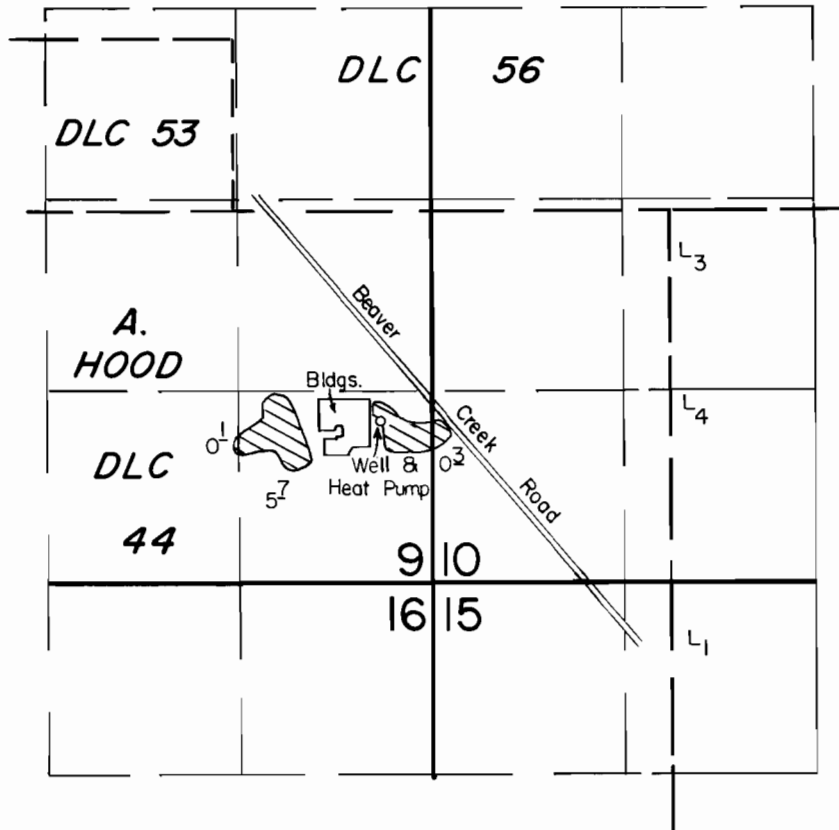

Well Loc. : 1110' N. & 360' W. from SE Cor. Sec. 9.

Scale : 1" = 1320'

**FINAL PROOF SURVEY**  
UNDER

Application No. ~~G-6908~~ Permit No. ~~G-6685~~.....  
IN NAME OF

OREGON CITY PUBLIC SCHOOL DISTRICT NO. 62

Surveyed AUG. 23, 1985, by T. Warren.....