


T.3S.,R.IW.,W.M.

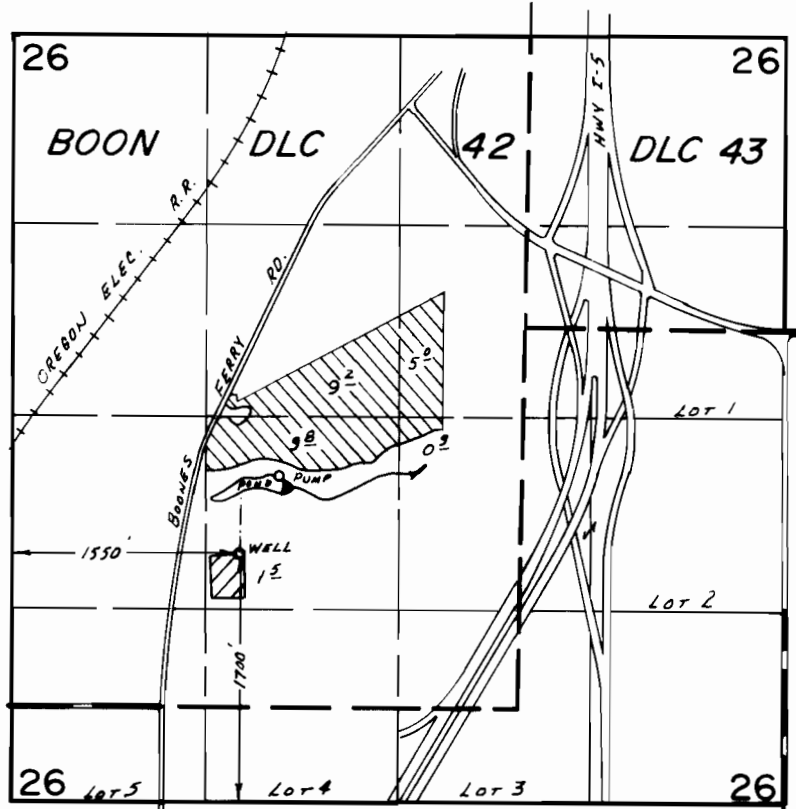

SCALE: 1" = 1320'

-  PRIMARY
-  SUPPLEMENTAL

FINAL PROOF SURVEY
UNDER

Application No. G-5931... Permit No. G-6837.....
IN NAME OF

.....FRANK MORISHITA.....

Surveyed Aug. 14.... 19.84, by B.W. BISHOP.....

INSPECTION #
41005 278 134D