


T.6 S., R. 2 E., W.M.

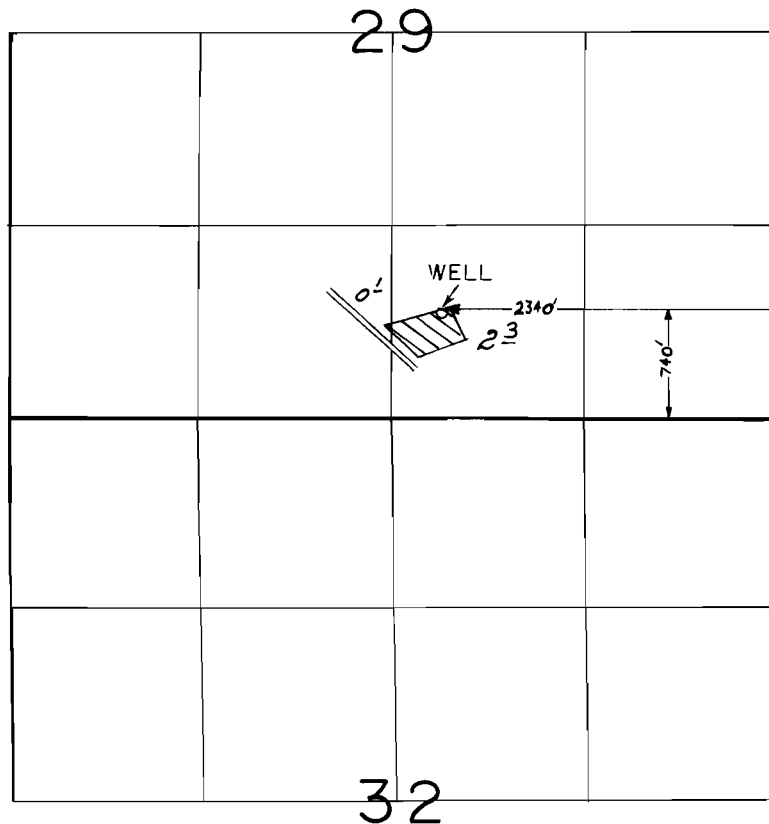

SCALE: 1" = 1320'

FINAL PROOF SURVEY
UNDERApplication No. G-8503 Permit No. G-7789
IN NAME OF

TERRY CLANCY DEAN

Surveyed APRIL 10 1986, by T. M. WARREN