


# T.3S.R.IE.W.M.

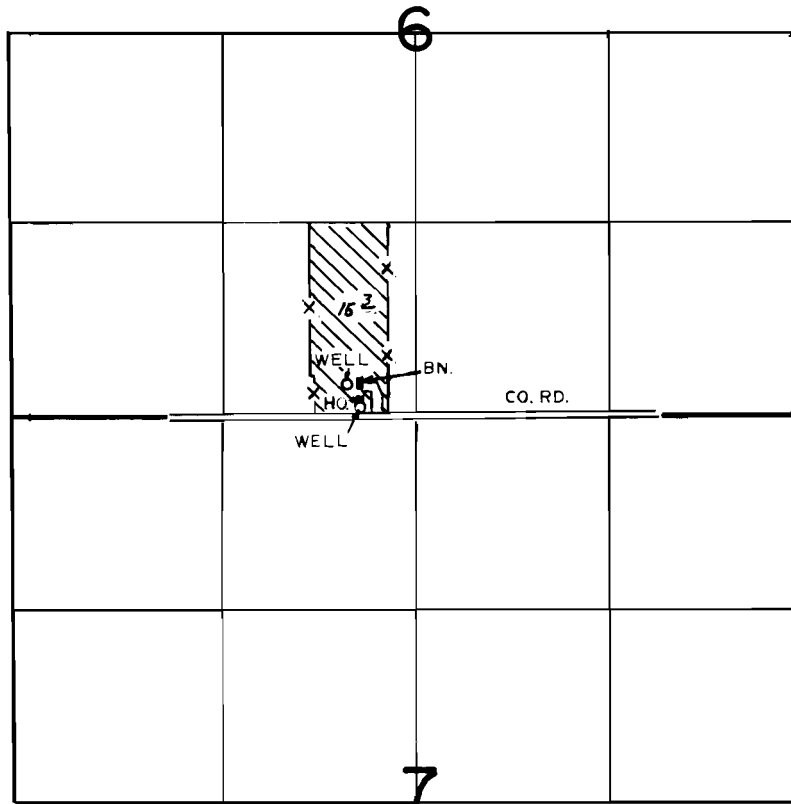

WELL LOC.: 60' N. & 400' W. FROM S. 1/4 COR. SEC. 6 (PERMIT NO. G-6568)  
210' N. & 460' W. FROM S. 1/4 COR. SEC. 6 (PERMIT NO. G-8361)

## FINAL PROOF SURVEY UNDER

Application No. ~~G-8979~~ Permit No. ~~G-8361~~.....  
IN NAME OF

.....LAKE GROVE GARDEN CENTER, INC.....

Surveyed MAR 7, 1980, by R.G. MUCKEN.....