


T. 3 S., R. 1 E., W. 4 M.

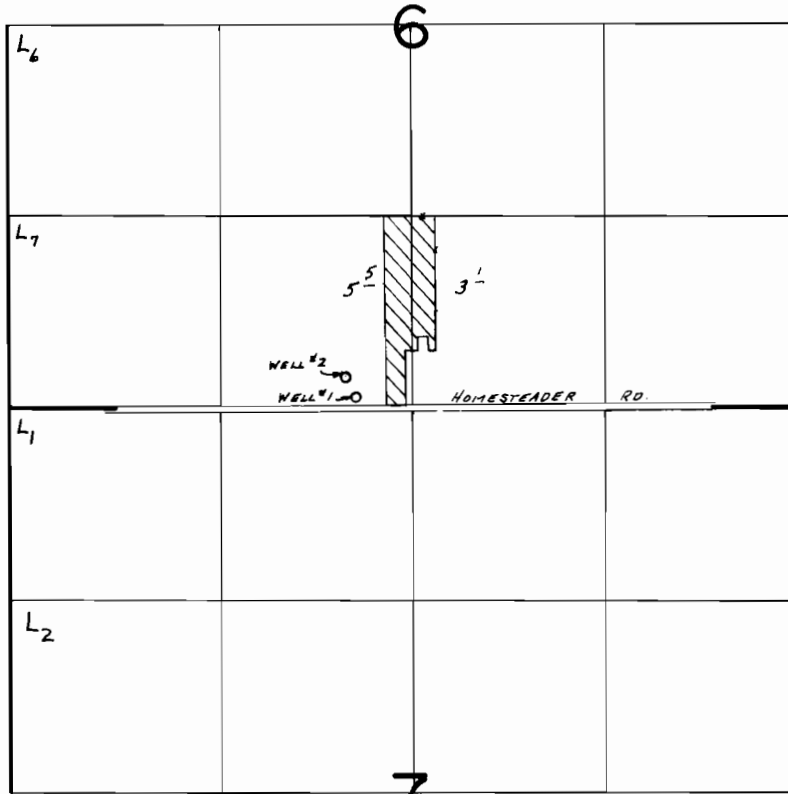

WELLS LOC: #1- 60'N. & 400'W, #2- 210'N. & 460'W, BOTH FROM THE 3/4 COR. SEC. 6.

SCALE: 1" = 1320'

## FINAL PROOF SURVEY UNDER

Application No. G:9492. Permit No. G:8892....  
IN NAME OF

LAKE GROVE GARDEN CENTER, INC.

Surveyed AUG. 15... 19.84, by B.W. BISHOP.....