


T. 4 S., R. 1 E., W. M.

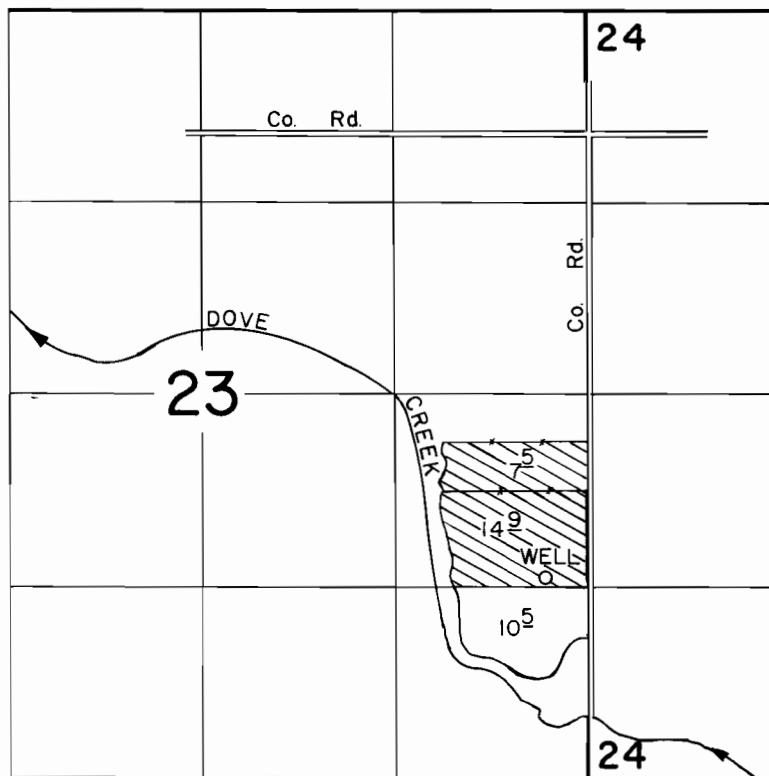

WELL LOC: 1390' N. & 300' W. FROM THE SE. CORNER SEC. 23

SCALE: 1" = 1320'

FINAL PROOF SURVEY

UNDER

Application No. G-9359 Permit No. G-8644
IN NAME OF

DAVID J. KOCH

Surveyed JULY 8, 1985, by T. WARREN