

Form 9180-31
(June 1967)

UNITED STATES
DEPARTMENT OF THE INTERIOR
BUREAU OF LAND MANAGEMENT


Project
Contract Number

4946

Map

SECTION DIAGRAM

Township 28 S.	Range 18 E.	Section 35	Meridian W. 11.	District Lakeview
Map No. South St. Patrick Reservoir				Date 11-29-78

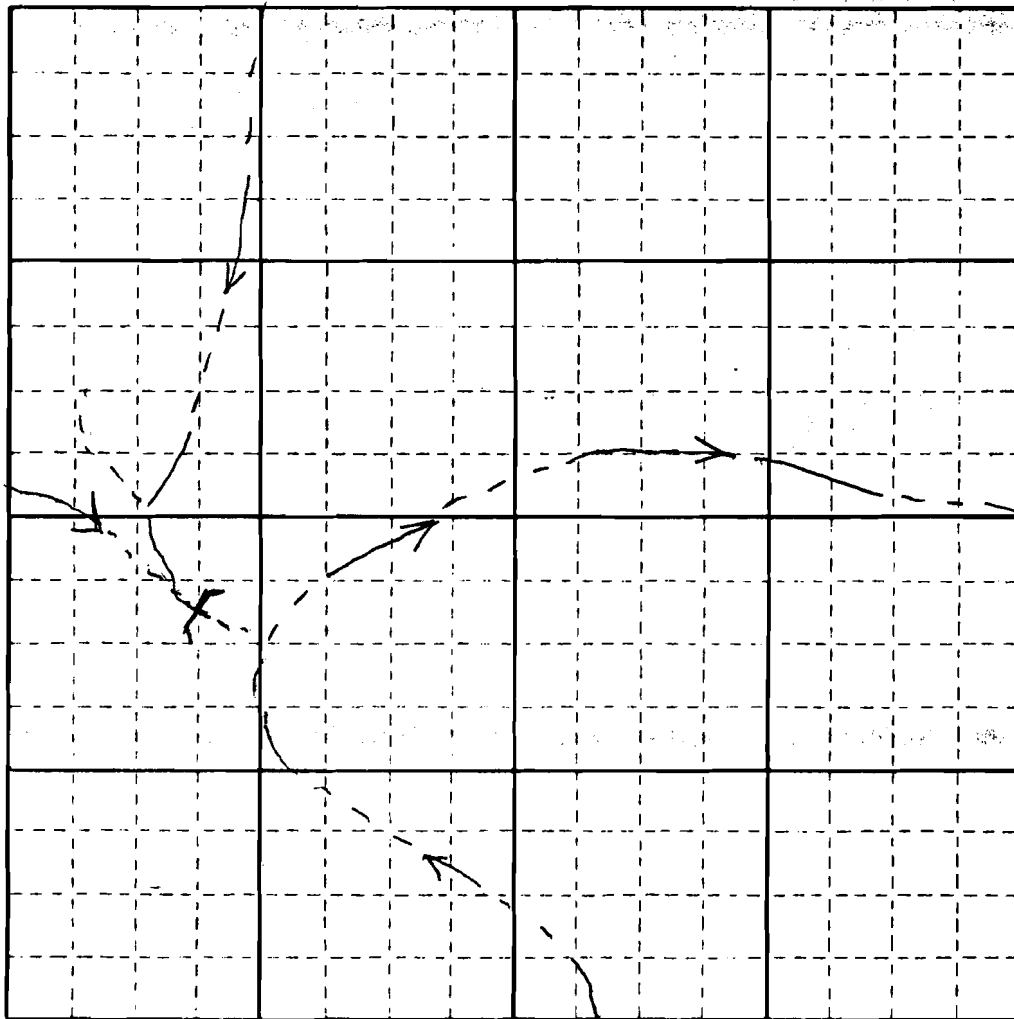

SCALE: 1" = 1,000 FT.

LEGEND

Application No. *R-58136*
Permit No. *R 7948*

☐ DAM IS 1000' E AND
☐ 3170' S OF SEC.
☐ COR. 26, 27, 34, 35
☐