


G-7433

55094



T. 38 S., R. 19 & 20 E., W.M.

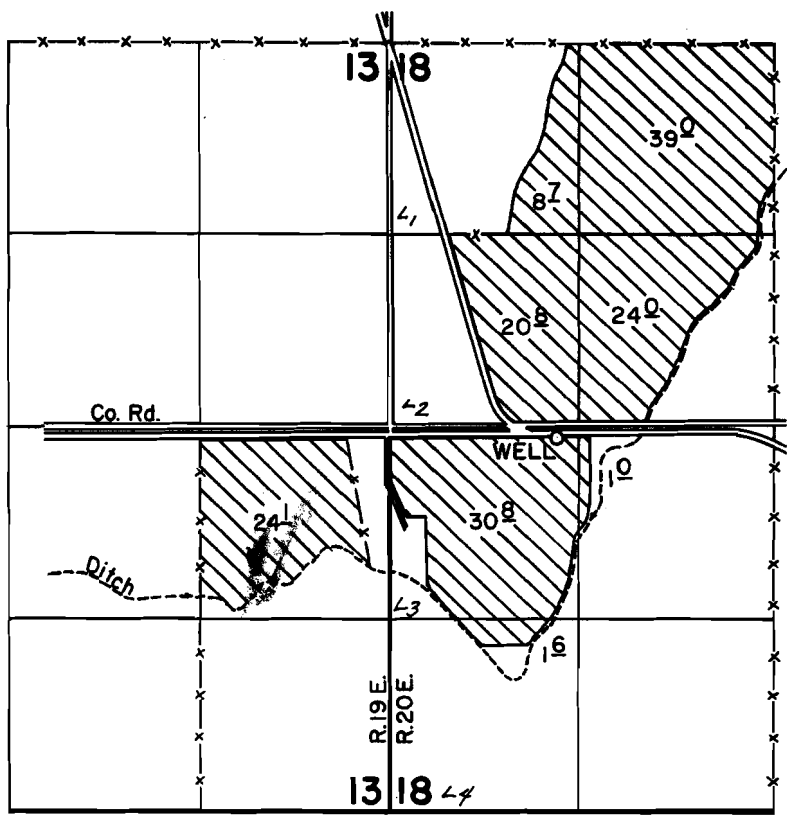

WELL LOC: 2550' N. & 1150' E. FROM THE S.W. CORNER SEC. 18

SCALE: 1" = 1320'

**FINAL PROOF SURVEY**  
UNDER

Application No. G-8032. Permit No. G-7433...  
IN NAME OF

.....70 RANCH INC.....

Surveyed JUNE 9, 1980, by C. L. Hughes.....