
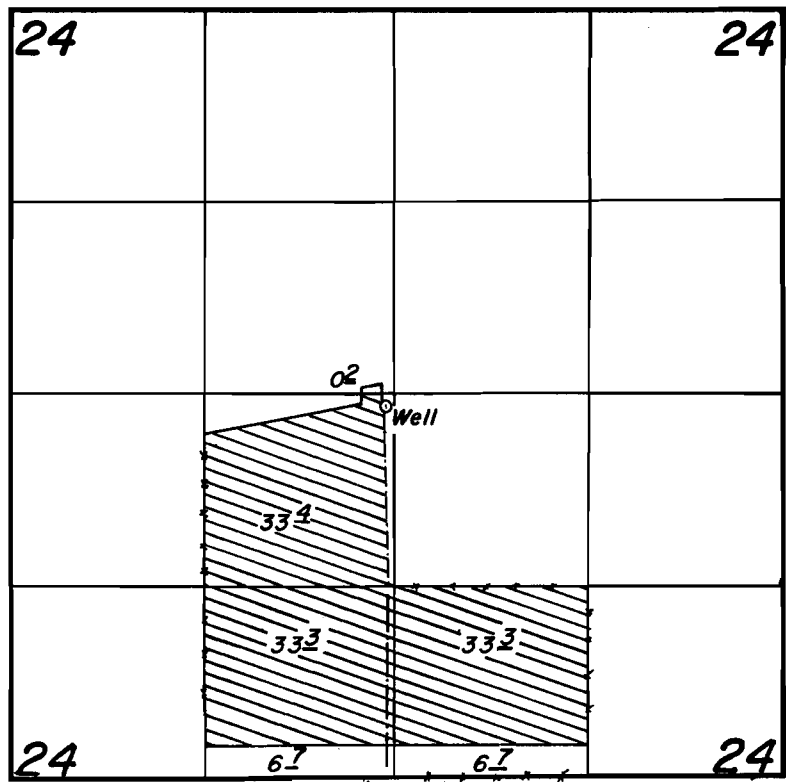


G. 7887  
55095  
T9404

# T. 26 S., R. 17 E., W. M.

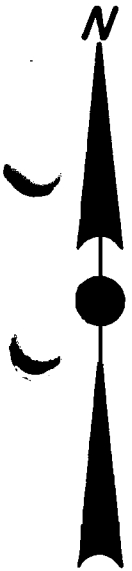

Well Located: 2550' N. & 50' W. from the S. 1/4 Corner Sec. 24

1" = 1320'

## FINAL PROOF SURVEY UNDER

Application No. G-8540. Permit No. G-7887.....  
IN NAME OF

DEPARTMENT OF VETERANS' AFFAIRS

Surveyed OCT. 30.... 1984., by LESUE OLSON.....