



T. 26S., R. 19E., W. M.

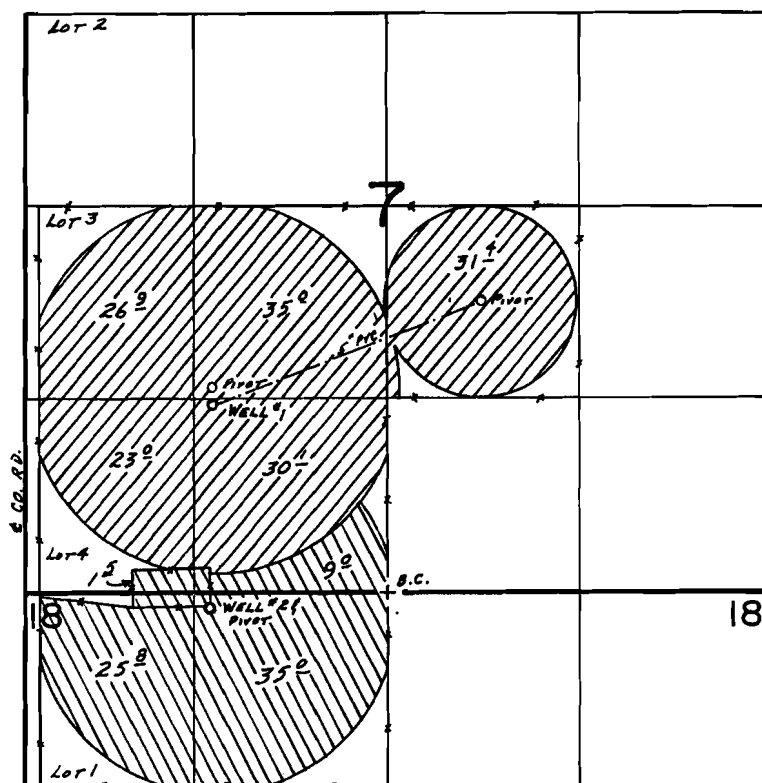

WELLS LOC.: #1-1280' N. & 1200' W.; #2-100' S. & 1210' W., BOTH FROM THE SOUTH 1/4 COR. SEC. 7.

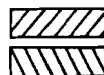

Well No. 1

Well No. 2

Scale: 1" = 1320'

FINAL PROOF SURVEY UNDER

Application No. G-8838. Permit No. G-8271.....
IN NAME OF

.....ARTHUR J. STEWART.....

Surveyed Oct. 11 & 12 1984, by B.W. BISHOP.....