


G-9325

55101

T8580

T.25S., R.18E., W.M

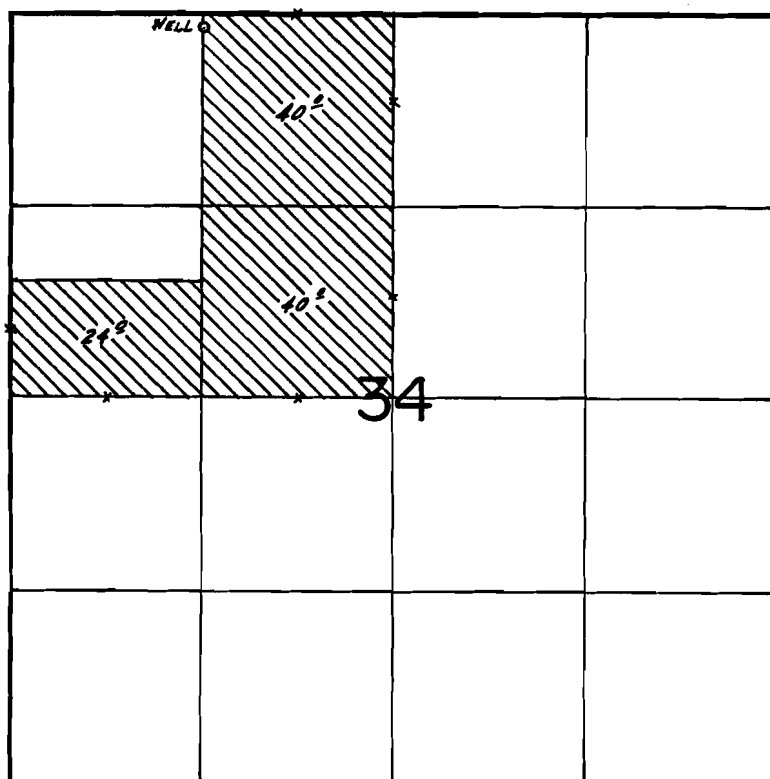

WELL LOC.: 90' S. & 1320' E. FROM NW COR. SEC. 34

SCALE: 1"=1320'

FINAL PROOF SURVEY
UNDER

Application No. G-9596. Permit No. G-9325.....
IN NAME OF

.....LYLE &/or HELEN DAMEWOOD.....

Surveyed Sept. 12... 1985, by B.W. BISHOP.....