


G-9329
55102

T.27S., R.18E., W.M.

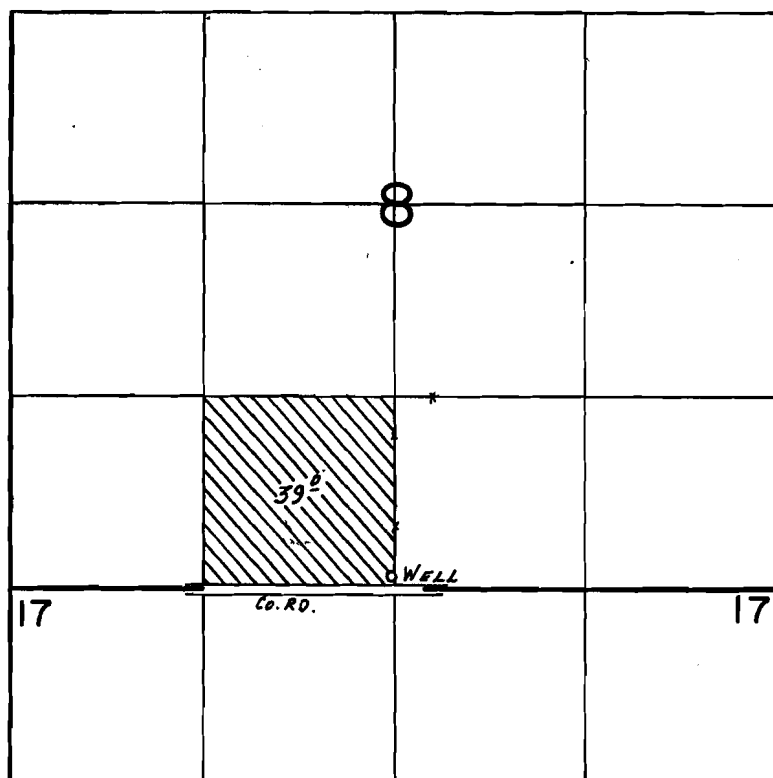

WELL LOC.: 80' N. & 30' W. FROM S. 1/4 COR. SEC. 8.

SCALE: 1"=1320'

FINAL PROOF SURVEY UNDER

Application No. G-10313 Permit No. G-9329....
IN NAME OF

LEE CHISM REFORESTATION CO., INC.

Surveyed Sept. 13, 1985, by B.W. BISHOP.....