


T.20S.,R.5W.,W.M.
Section I

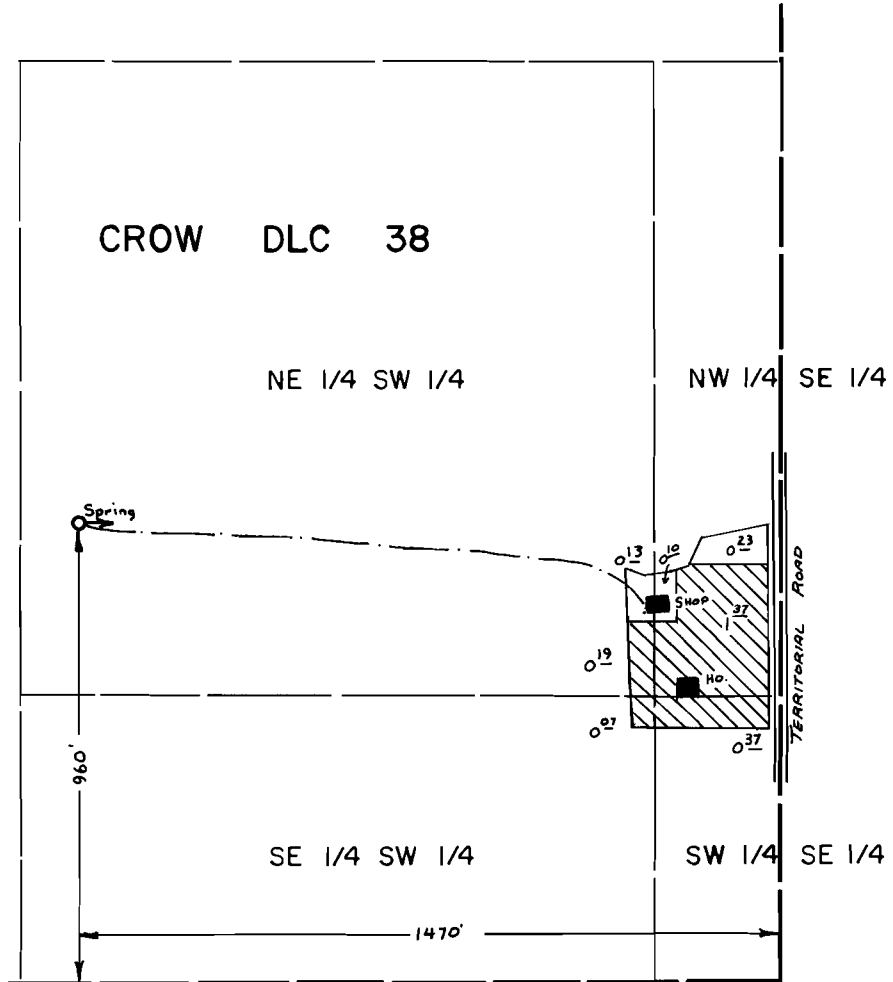

SCALE: 1"=400'

FINAL PROOF SURVEY
UNDER

Application No. 58071... Permit No. 43955.....

IN NAME OF
**CLIFFORD W. &
DARLENE J. STEVENS**.....

Surveyed July 13, 1982., by L.M. TOLL.....