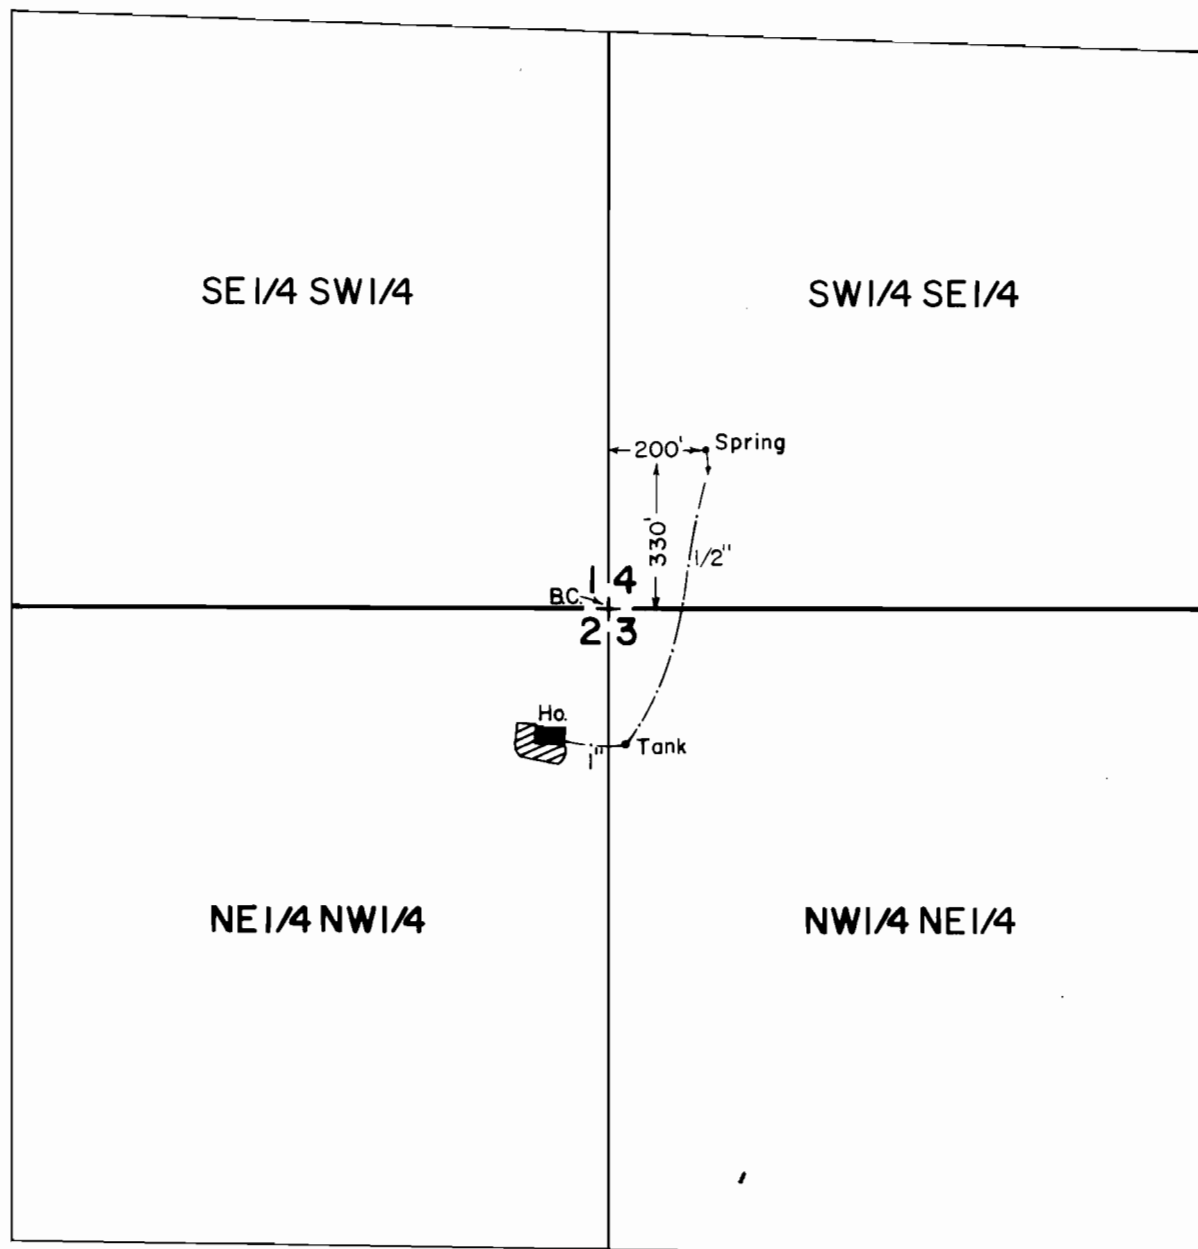


T.17S., R.12W., W.M.

**FINAL PROOF SURVEY**

SCALE: 1" = 400'

UNDER

Application No. 56874.. Permit No. 42688.....

IN NAME OF

FORREST G. & LYNNE G. GRIGSBY.

Surveyed Sept. 26. 1985., by T. WARREN.....