
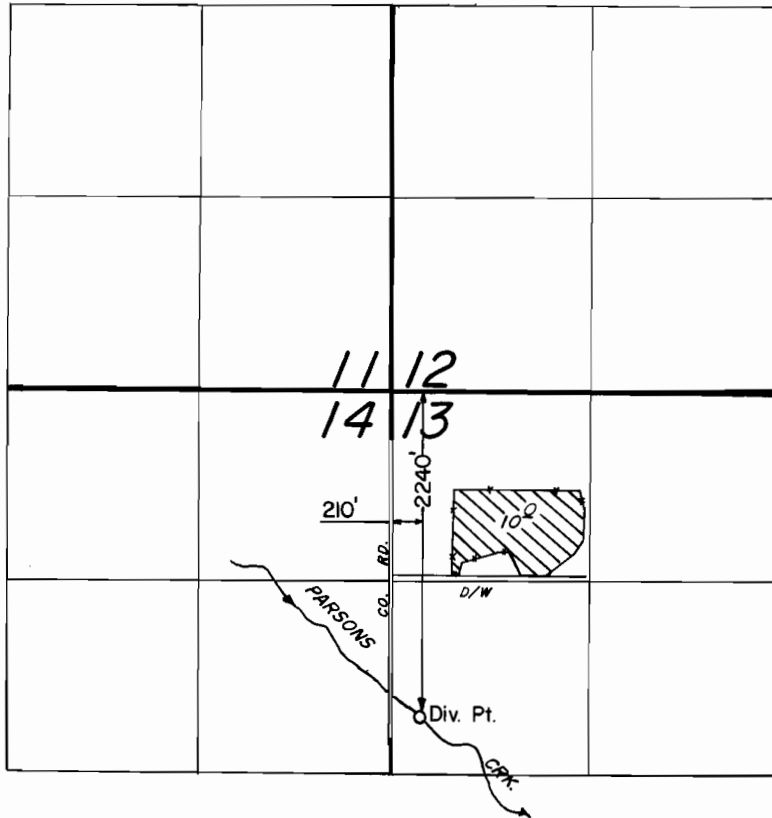


T.16 S., R.2 W., W. M.

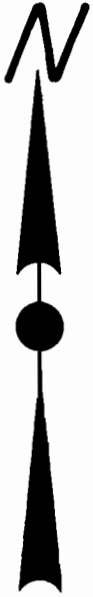

Scale: 1" = 1320'

**FINAL PROOF SURVEY**  
UNDER

Application No. 64561 Permit No. 47291

IN NAME OF

CHATOM CO., LTD.

Surveyed May 22, 1985, by T. Warren

DBQ-24-144  
PT-1985-A  
TMW