T.5S.,R.1W.,W.M.

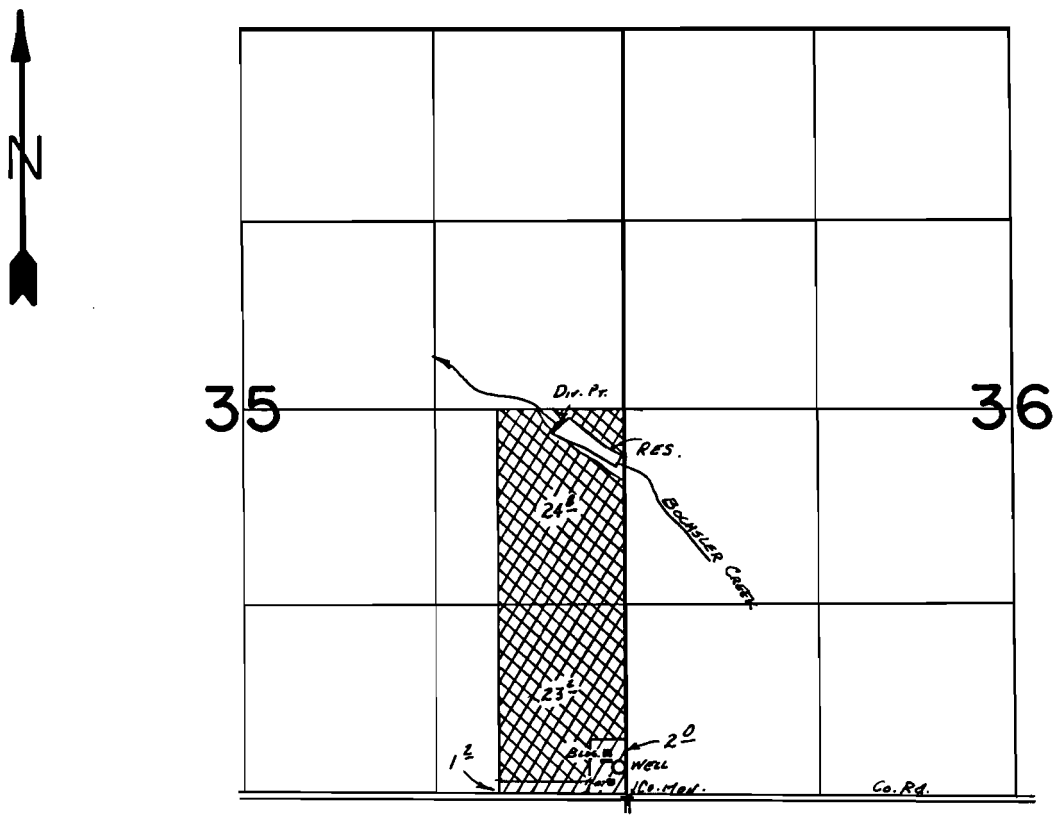

WELL LOCATION: 200 ft. N. and 50 ft. W. from the SE Cor. Sec. 35
DIV. PT. LOC.: 2550 ft. N. and 450 ft. W. from the SE Cor. Sec. 35

SCALE: 1" = 1320'

FINAL PROOF SURVEY

UNDER

R-60348 R-8172
60349 45033
Application No. G-7006 Permit No. G-6508

Supplemental
Primary

IN NAME OF

DANIEL HAMMELMAN

Surveyed Oct. 15, 1981, by S. C. BROWN
Mar. 25 1986 T. M. WARREN

4/9/86

41047-278-109D BWB
PFS 1986-A

OFN-3LL-174