


T. 9S., R. 3W., W.M.

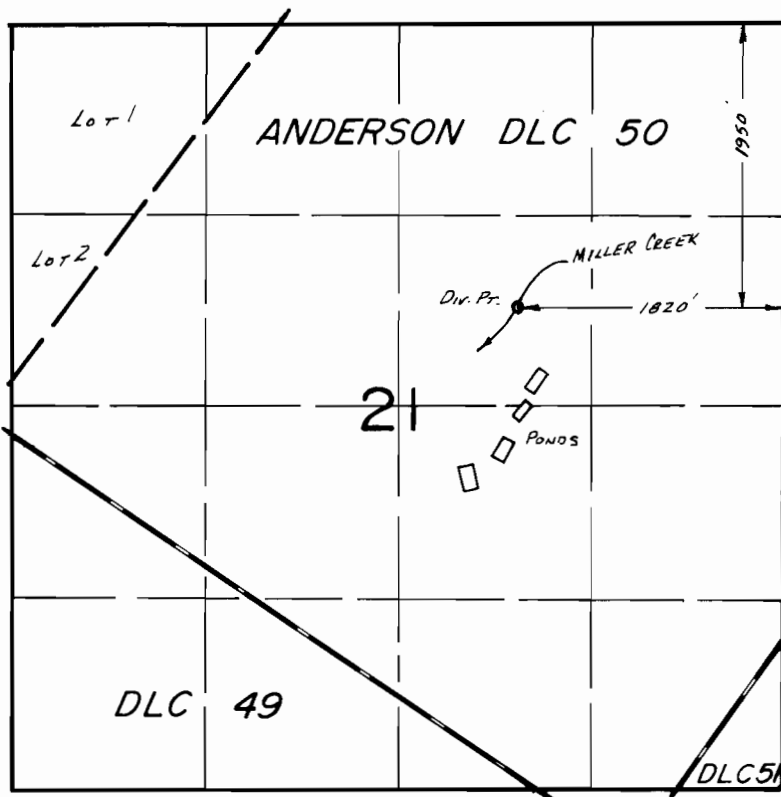

SCALE: 1"=1320'

FINAL PROOF SURVEY
UNDER

Application No. 55103... Permit No. 42694.....
IN NAME OF

...U.S. FISH & WILDLIFE SERVICE

Surveyed May 13..... 19.85, by P.R. PAGTER.....