


T.6S.,R.1W.,W.M.

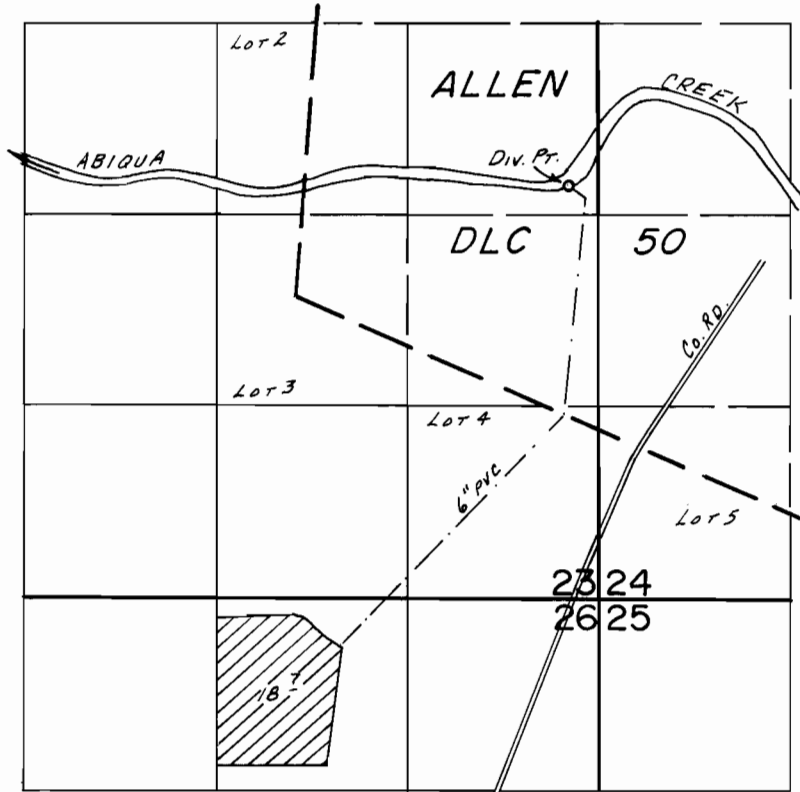

Div. Pt. Loc.: 2850' N. & 200' W. FROM SE COR. SEC. 23

SCALE: 1" = 1320'

FINAL PROOF SURVEY UNDER

Application No. 68604. Permit No. 49561.....
IN NAME OF

.....HERMAN GOSCHIE.....

Surveyed Apr. 7..... 19.86, by T. M. WARREN.....

5-1-86

BWB