


T. 10S., R. 2W., W.M.

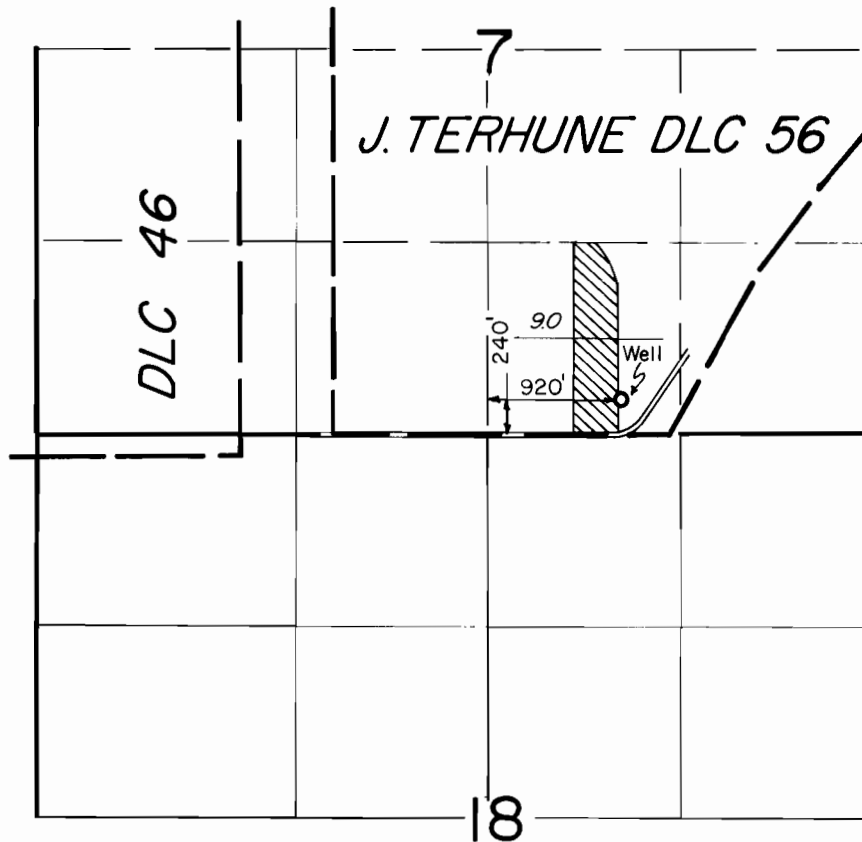

**FINAL PROOF SURVEY**  
UNDER

Application No. G-7334 Permit No. G-7359

IN NAME OF

**CHARLES HART, JR.**

Surveyed SEPT. 5, 1979, by *[Signature]*