


# T.4S.,R.1W.,W.M.

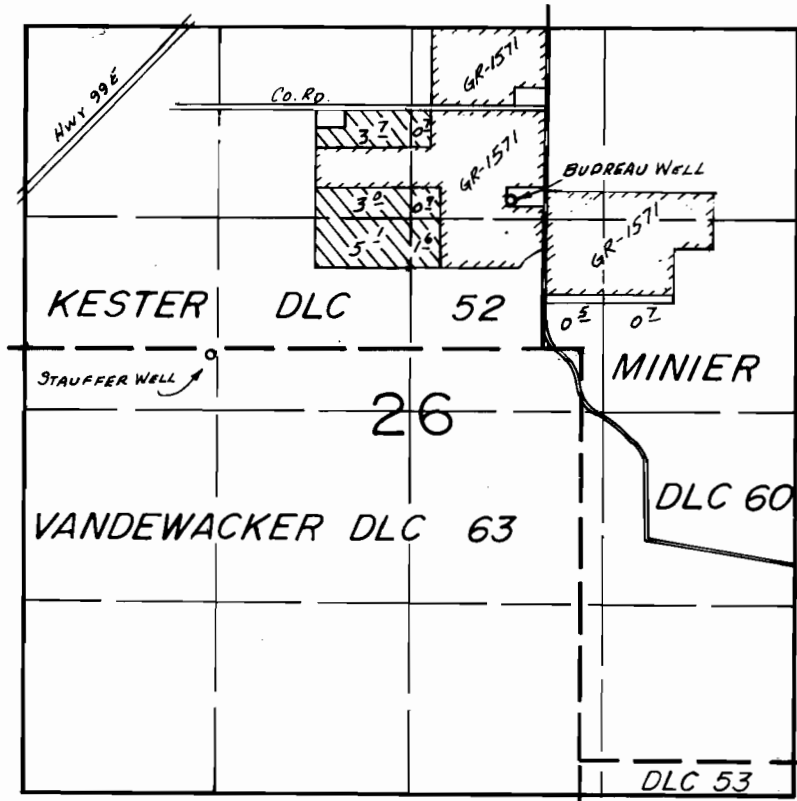

BUDREAU WELL LOC.: 1020' N. & 230' W. FROM SE COR. KESTER DLC 52.  
 STAUFFER WELL LOC.: 40' S. & 2550' W. FROM NE COR. VANDEWACKER DLC 63.

SCALE: 1" = 1320'

## FINAL PROOF SURVEY UNDER

Application No. G-9159. Permit No. G-8481.....  
 IN NAME OF

JAMES BUDREAU

Surveyed Apr. 16... 19.86, by T.M. WARREN...

4/29/86

41047-278-115L *AWB*