


T. 8 S., R. 2 W., W. M.

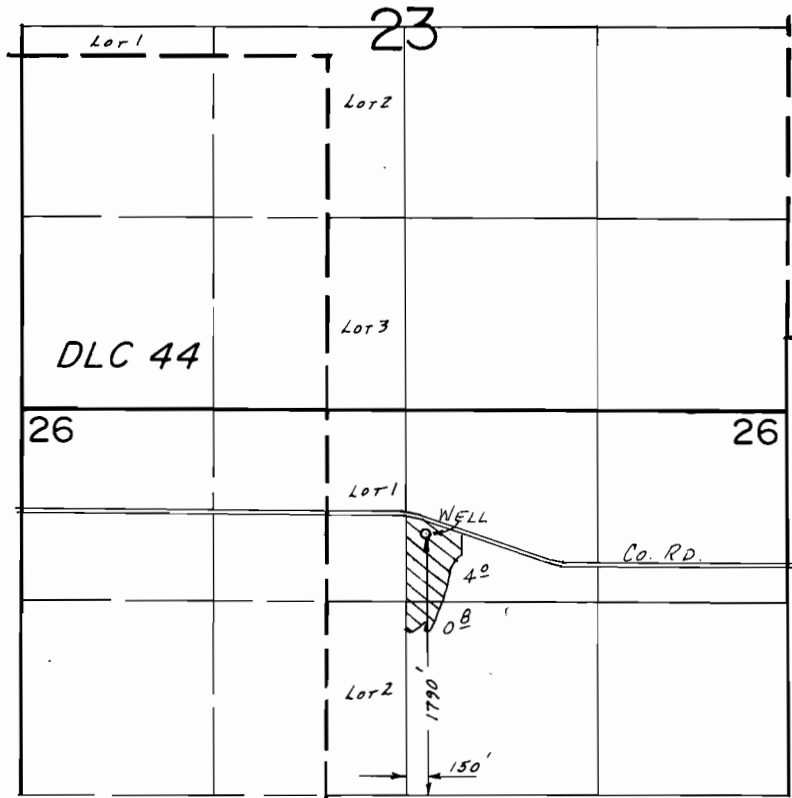

SCALE: 1" = 1320'

**FINAL PROOF SURVEY**  
UNDER

Application No. G-9300. Permit No. G-8555.....  
IN NAME OF

.....OTTO PIKL.....

Surveyed Aug. 14, 1985, by T.M. WARREN.....