


T. 8 S., R. 2 W., W. M.

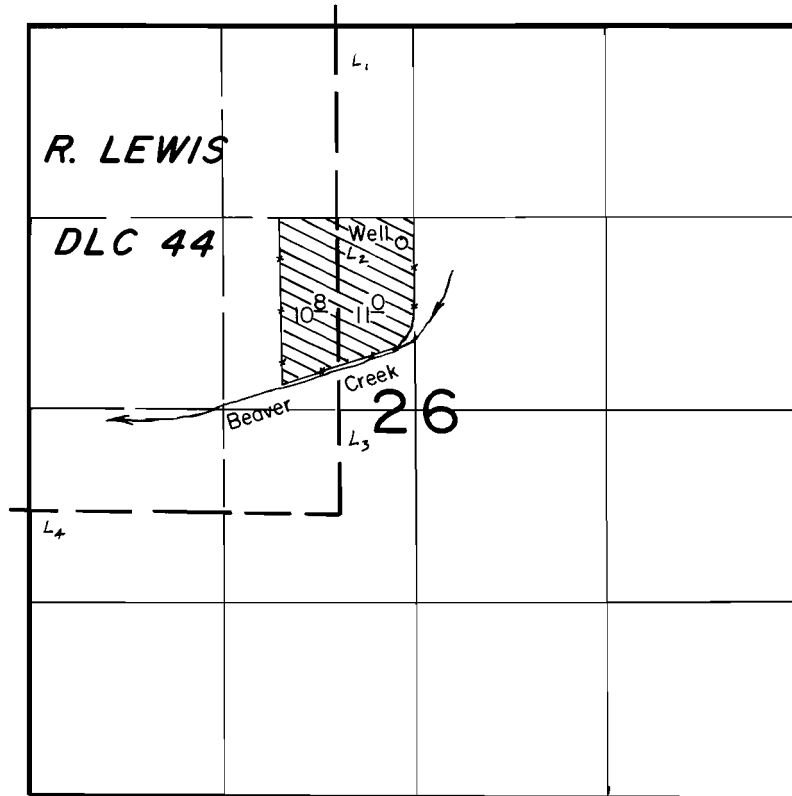

Well Loc. : 1150' N. & 80' W. from C. 1/4 Sec. 26.

Scale. : 1" = 1320'

FINAL PROOF SURVEY
UNDER

Application No. G-10522 Permit No. G-9582.....

IN NAME OF

CAROL ANN BINKLEY

Surveyed April 24, 1986., by T. M. Warren.....