


T. 7 S., R. 2 W., W.M.

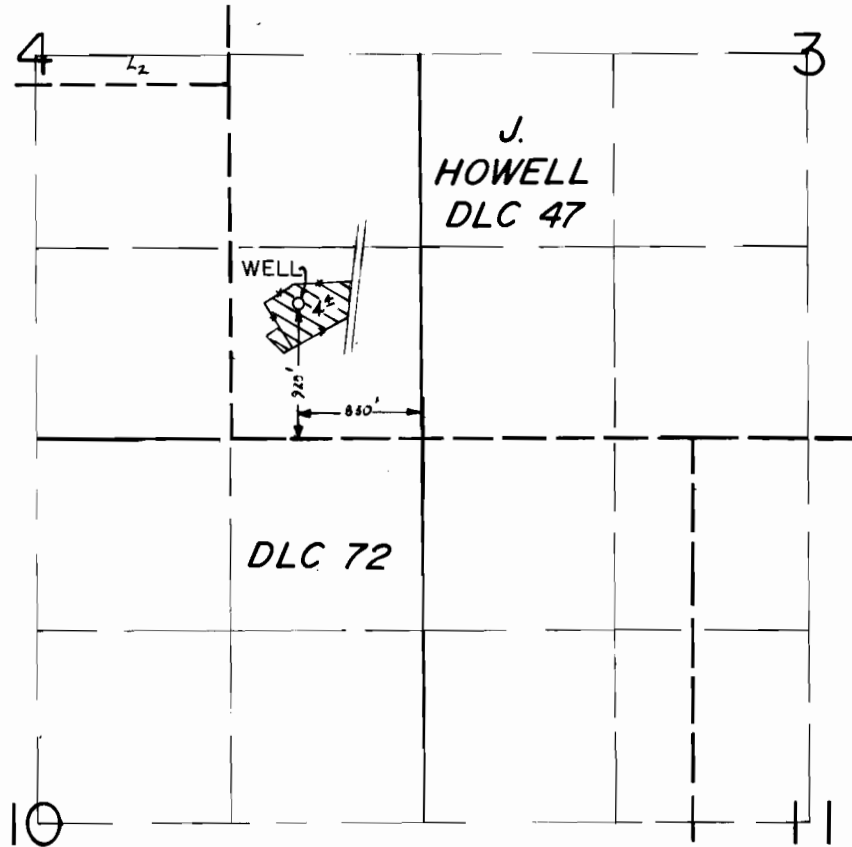

SCALE: 1" = 1320'

**FINAL PROOF SURVEY**  
UNDER

Application No. G-10439 Permit No. G-9610

IN NAME OF

WAYNE GOODE

Surveyed APRIL 17, 1986, by T. M. WARREN