


T. 7 S., R. 2 W., W.M.

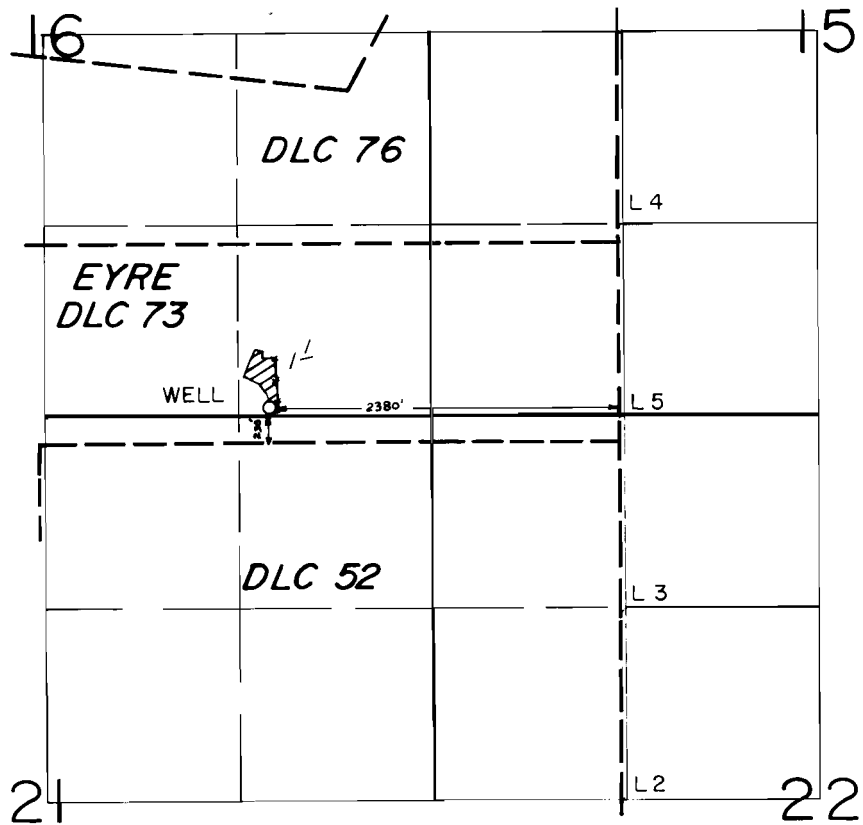

SCALE 1" = 1320'

FINAL PROOF SURVEY UNDER

Application No. G-10459 Permit No. G-9640
IN NAME OF

BRUCE A. AND MYRNA J. ESTES

Surveyed APRIL 17 1986, by T. M. WARREN